

FEB 28 2000

FILE DO NOT MAIL

LAND CORNER RECORDATION CERTIFICATE  
Filing Requirement of Act 74, Mich. P.A. 1970

SECTION

CITY OF DEARBORN  
or corners in

<u>WAYNE</u> (County)	Located In:	Corner Code #
Public Land Survey	T <u>2S</u> R <u>10E</u>	<u>E-5</u>
	T _____ R _____	_____
	T _____ R _____	_____
	T _____ R _____	_____
Property Controlling in Section	S _____ T _____ R _____	_____
	S _____ T _____ R _____	_____
Miscellaneous Property in Sec.	S _____ T _____ R _____	_____
	S _____ T _____ R _____	_____

Liber-30855 Page-4  
99593158 12/29/1999  
F.F. Vnunnhlood, Wayne Co. Register of Deeds

Compliance with  
ACT 345, P.A. 1990

APPROVED ON: 12-9-99  
WAYNE COUNTY REMONUMENTATION  
PEER GROUP COMMITTEE

Register of Deeds Stamp & File Number

1. Lot No. \_\_\_\_\_, Recorded Plat \_\_\_\_\_  
2. Private Claims \_\_\_\_\_

LAWRENCE R. FEINDT, in a field survey on December 2, 1999  
do hereby state that under requirements of P.A. 74, Michigan P.A. of 1970, the corner points mentioned in lines 1 and 2 above were in conformance with regulations and rules therefore as required in the current manual of survey instructions of the United States Department of the Interior, Bureau of Land Management or by a decree of a Court of Law and /or that the corner points mentioned in lines 3, 4 and 5 above were in conformance with the rules of the Michigan Board of Land Surveyors or by a Decree of a Court of Law; established, re-established, monumented, discovered, found as expressed below:

1	A	B	C	D	E	F	G	H	I	J	K	L	M
2		6		5		4		3		2		1	
3													
4		7		8		9		10		11		12	
5					●								
6		18		17		16		15		14		13	
7													
8		19		20		21		22		23		24	
9													
10		30		29		28		27		26		25	
11													
12		31		32		33		34		35		36	
13													

NOTE: Not more than 2 corners, all in the same town and range, may be recorded on this certificate.

A. Description of original monument and accessories and/or subsequent restoration:

**E-5 CORNER COMMON TO SECTIONS 8, 9, 16 & 17, T2S-R10E**

GENERAL LAND OFFICE	WAYNE COUNTY BUREAU OF TAXATION	WAYNE COUNTY ROAD COMMISSION
Set Sec. corner	Iron	Feb 10, 1970 By: E. Johns
B. Ash 10" S17°W 22 Lks (14.52')	NE'ly - 59.25' - Ed. Pole (GONE)	Iron in box
Elm 20" N88°E 4 Lks (2.64')	SE'ly - 52.44' - Ed. Pole (GONE)	NE'ly - 73.45' - Back Sidewalk (FOUND)
December 23, 1816	SW'ly - 84.30' - Ed. Pole (GONE)	SE'ly - 77.60' - Edison Pole (GONE)
By: Joseph Fletcher	NW'ly - 62.45' - Ed. Pole (GONE)	SW'ly - 92.95' - Edison Pole (FOUND)
		NW'ly - 78.68' - Edison Pole (GONE)

B. Description of corner evidence found and/or method applied in restoring or reestablishing corner:

**E-5 CORNER COMMON TO SECTIONS 8, 9, 16 & 17, T2S-R10E**

Found 1 1/2" rod in monument box in the center line of Northbound Telegraph Road and Ford Road. Corner was confirmed with irons found in "FORD-TELEGRAPH ROAD SUBDIVISION" as recorded in Liber 49 Page 40; "GOLDEN ACRES SUBDIVISION" as recorded in Liber 50 Page 86; "NELSON BROTHERS SUBDIVISION" as recorded in Liber 51 Page 55, "Telegraph-Ford Subdivision" as recorded in Liber 53 Page 14 and by comparisons to WPA surveys conducted in the 1930's.

Distance to corner E-6 Measured 2628.60' (PLAT = 2628.95')  
Distance to corner D-5 Measured 2647.25' (WPA = 2647.13' PLAT = 2647.80)


C. Description of monument for corner and accessories established to perpetuate locating the position of the corner:

**E-5 CORNER COMMON TO SECTIONS 8, 9, 16 & 17, T2S-R10E**

Found 1 1/2" rod in monument box in concrete pavement at the intersection of Telegraph Road and Ford Road. Corner is accepted as a careful and faithful reestablishment of the position of the original corner.

WITNESSES:

N29°E 69.50' Set nail and WCR tag in NW side of utility pole  
N36°E 72.57' Back of sidewalk intersection (R=73.45')  
S30°E 89.37' Set nail & WCR tag in the SW side of utility pole  
S38°W 92.85' Found nail & WCRC tag in SE side of utility pole (R=92.95)  
S38°W 93.16' Found nail & MSHD tag in NW side utility pole  
N44°W 76.04' Set nail & Wayne Co. Remon disk in NE utility pole

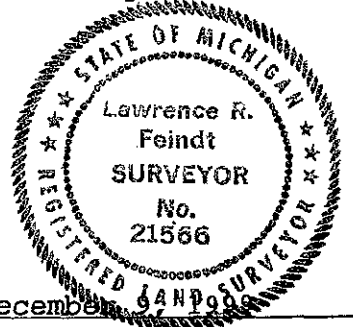

Signed by Lawrence R. Feindt Date December 29, 1999

Surveyor's Michigan License No. 21566

R LCR 9 4R1P3 A DP2