

RF

FEB 28 2000

SECTION

FILE DO NOT MAIL

LAND CORNER RECORDATION CERTIFICATE
Filing Requirement of Act 74, Mich. P.A. 1970

CITY OF DEARBORN
or corners in

WAYNE

(County)

Located In:

Corner Code #

Public Land Survey

T 2S R 10E

E-6

Property Controlling Section

S T R

Miscellaneous Property in Sec.

S T R

Liber-30855 Page-5
99593172 12/12/1999
F.E. Youngblood, Wayne Co. Register of Deeds

Compliance with
ACT 345, P.A. 1990

APPROVED ON: 12-9-99
WAYNE COUNTY REMONUMENTATION
PEER GROUP COMMITTEE

Register of Deeds Stamp & File Number

Lot No. Recorded Plat

Private Claims

LAWRENCE R. FEINDT, in a field survey on DECEMBER 2, 1999
to hereby state that under requirements of P.A. 74, Michigan P.A. of 1970, the corner points
mentioned in lines 1 and 2 above were in conformance with regulations and rules therefore as
equipped in the current manual of survey instructions of the United States Department of the Interior,

Grid table with columns A-M and rows 1-13. Cell (6, F) contains a black dot.

NOTE: Not more than 2 corners, all in the same town and range, may be recorded
on this certificate.

A. Description of original monument and accessories and/or subsequent restoration:

E-6 CORNER COMMON TO SECTIONS 16 & 17 T2S-R10E

GENERAL LAND OFFICE

Set 1/4 Sec. post

W. Ash 10" South 6 Links (3.96")

Gum 10" N89°W 19 Links (12.54')

DEC 23, 1816

By: Joseph Fletcher

B. Description of corner evidence found and/or method applied in restoring or reestablishing corner:

E-6 CORNER COMMON TO SECTIONS 16 & 17 T2S-R10E

Found no corner or evidence of original corner. Corner was reestablished from property irons
found in "DEARBORN HIGHLANDS SUBDIVISION" recorded in Liber 40 Page 84; and "ASSESSORS DEARBORN
PLAT No. 2" recorded in Liber 69 Page 43.

Distance to corner E-5 Measured 2628.60' (PLAT = 2628.95')
Distance to corner E-7 Measured 2633.05' (PLAT = 2633.19' MDOT = 2633.01')

C. Description of monument for corner and accessories established to perpetuate locating the position of the corner:


E-6 CORNER COMMON TO SECTIONS 16 & 17 T2S-R10E

Due to extremely heavy traffic no corner was set in the center lines of Telegraph Road and
Wilson Avenue. In place of the corner two offset monuments were set. Road surface is concrete
with asphalt overlay.

The selected location is accepted by the contractor and is generally accepted by professional
surveyors as the best available evidence of the original corner.

WITNESSES TO COMPUTED POSITION:

- 18" Locust N40°W 64.35' Set nail and WCR disk #21566 in South side
Util Pole N74°E 94.00' Set nail and WCR tag in NW side
11" Maple S28°E 58.19' Set nail and WCR tag in West side
20" Locust S55°W 103.47' Set nail and WCR tag in SE side
T-iron drilled in concrete sidewalk N41°E 50.00' (Offset monument)
T-iron drilled in concrete sidewalk S41°W 50.00' (Offset monument)

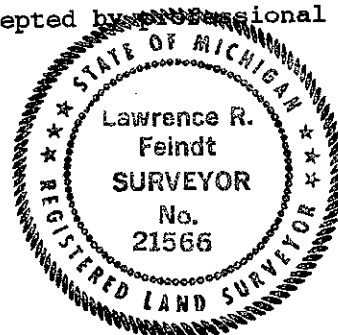

Signed by Lawrence R. Feindt
Surveyor's Michigan License No. 21566

Date December 9, 1999

R LCR 9 4 R 1Pg A