

SURVEY & REMONUMENTATION

\$ 4.00 REMONUMENTATION

\$ 7.00 DEED

8 DEC 95 9:44 A.M. RECEIPT 68

LAND CORNER RECORDATION CERTIFICATE

City of Dearborn APR 05 1996

Filing Requirement of Act 74, Mich. P.A. 1970

REGISTERED FOREST R. 100700 000, REGISTER OF DEEDS WAYNE COUNTY, MI

For corners in

Wayne (County)

COMMISSION

Located In:

Corner Code #

LIBER 28451 PAGE 029

- 1. Public Land Survey T 2S R 10E E-9
 T _____ R _____
 T _____ R _____
 T _____ R _____
- 2. Property Controlling S _____ T _____ R _____
 in Section S _____ T _____ R _____
- 3. Miscellaneous S _____ T _____ R _____
 Property in Sec. S _____ T _____ R _____

Compliance with ACT 345, P.A. 1990

APPROVED ON: 12-6-95 *RL*
 WAYNE COUNTY REMONUMENTATION
 BOARD OF SURVEYORS

Register of Deeds Stamp & File Number

95262308

- 4. Lot No. _____, Recorded Plat _____
- 5. Private Claims _____

	A	B	C	D	E	F	G	H	I	J	K	L	M
2	6	5	4	3	2	1							
3													
4	7	8	9	10	11	12							
5													
6	18	17	16	15	14	13							
7													
8	19	20	21	22	23	24							
9													
10	30	29	28	27	26	25							
11													
12	31	32	33	34	35	36							

Lawrence R. Feindt

I, Lawrence R. Feindt, in a field survey on November 30, 19 95, do hereby certify that under requirements of P.A. 74, Michigan P.A. of 1970, the corner points mentioned in lines 1 and 2 above were in conformance with regulations and rules therefore as required in the current manual of survey instructions of the United States Department of the Interior, Bureau of Land Management or by a decree of a Court of Law and/or that the corner points mentioned in lines 3, 4 and 5 above were in conformance with the rules of the Michigan Board of Land Surveyors or by a Decree of a Court of Law; established, re-established, monumented, re-monumented, recovered, found as expressed below:


NOTE: Not more than 4 corners, all in the same town and range, may be recorded on this certificate.

A. Description of original monument and accessories and/or subsequent restoration:

E-9) Corner Common to Sections 20, 21, 28 & 29, T 2 S, R 10 E
 GENERAL LAND OFFICE
 SET POST FOR CORNER
 SUGAR 12"-820 E-19 LINKS(12.54')
 W. ASH 9"-N38 E-31 LINKS(20.46')
 DECEMBER 22, 1916
 BY: JOSEPH FLETCHER, DS

B. Description of corner evidence found and/or method applied in restoring or reestablishing corner:

E-9) Corner Common to Sections 20, 21, 28 & 29, T 2 S, R 10 E
 No direct evidence of corner was found. Corner was reestablished from property irons found in "Wittleberger's Sub." as recorded in Liber 38, Page 56; "Robert M. Grindley's Subdivision No. 4" as recorded in Liber 29, Page 56; "Robert Grindley's Sub. No. 3" as recorded in Liber 29, Page 45; and undated and unrecorded "Private Plat of Fractional Section 21, T 2 S, R 10 E".

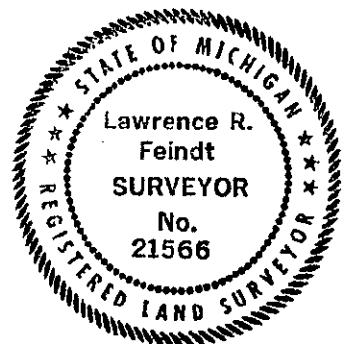

C. Description of monument for corner and accessories established to perpetuate locating the position of the corner:

E-9) Corner Common to Sections 20, 21, 28 & 29, T 2 S, R 10 E
 Set concrete monument with brass disk stamped #21566 at computed corner location in the seeded shoulder on the east side of north bound Telegraph Road. The selected location is accepted by the contractor and is generally accepted by professional surveyors as the best available evidence of the position of the original corner.
Witnesses: N40°E - 82.18' - Set nail and WCR tag in west face of 18" Oak
 S68°W - 114.68' - Set "X" cut in NW railroad bridge abutment wingwall
 N38°W - 169.98' - Set "X" cut in SE bolt of concrete light pole base
 N85°E - 15.50' - Set nail in northwest face of 9" Cedar and affixed Wayne County brass disk stamped with license #21566

Signed by Lawrence R. Feindt

Date December 7, 1995

Surveyor's Michigan License No. 21566

4R
7D
700