

DEC 22 1998

MAR 02 1999

FILE DO NOT MAIL

SECTION

Liber-30032

Page-19.0

LAND CORNER RECORDATION CERTIFICATE
Filing Requirement of Act 74, Mich. P.A. 1970

CITY OF DEARBORN
For corners in

WAYNE (County) Located In: Corner Code #
1. Public Land Survey T 2S R 10E E-10
2. Property Controlling in Section S T R
3. Miscellaneous Property in Sec. S T R
4. Lot No. , Recorded Plat
5. Private Claims

Compliance with ACT 345, P.A. 1990
APPROVED ON: 12-16-98
WAYNE COUNTY REMONUMENTATION PEER GROUP COMMITTEE
Register of Deeds Stamp & File Number

I, LAWRENCE R. FEINDT, in a field survey on DECEMBER 9, 1998 do hereby state that under requirements of P.A. 74, Michigan P.A. of 1970, the corner points mentioned in lines 1 and 2 above were in conformance with regulations and rules therefore as required in the current manual of survey instructions of the United States Department of the Interior, Bureau of Land Management or by a decree of a Court of Law and /or that the corner points mentioned in lines 3, 4 and 5 above were in conformance with the rules of the Michigan Board of Land Surveyors or by a Decree of a Court of Law; established, re-established, monumented, recovered, found as expressed below:

NOTE: Not more than 2 corners, all in the same town and range, may be recorded on this certificate.

A. Description of original monument and accessories and/or subsequent restoration:
E-10 CORNER COMMON TO SECTIONS 28 & 29 T2S-R10E
GENERAL LAND OFFICE
Set 1/4 Sec. post
Elm 9° N71°W 18 Links (11.88')
Maple 9° S39°W 18 Links (11.88')
DEC 21, 1816
By: Joseph Fletcher

B. Description of corner evidence found and/or method applied in restoring or reestablishing corner:
E-10 CORNER COMMON TO SECTIONS 28 & 29 T2S-R10E
Found no corner or evidence of original corner. Corner was reestablished from property irons found in "ROBERT M. GRINDLEY'S SUBDIVISION No.4 of LITTLE FARMS" recorded in Liber 29 Page 56; DEARBORN HEIGHTS SUBDIVISION" recorded in Liber 34 Page 30; and "MAPLE-TELEGRAPH SUBD'N" recorded in Liber 57 Page 51.


Distance to corner E-9 Measured 2641.27' (GLO = 2640')
Distance to corner E-11 Measured 2632.83' (MDOT = 2633.05')

C. Description of monument for corner and accessories established to perpetuate locating the position of the corner:
E-10 CORNER COMMON TO SECTIONS 28 & 29 T2S-R10E
Due to extremely heavy traffic no corner was set in the center lines of Telegraph Road and Princeton Avenue. In place of the corner two offset monuments were set. Road surface is concrete with asphalt overlay.

The selected location is accepted by the contractor and is generally accepted by professional surveyors as the best available evidence of the original corner.

- WITNESSES: Util pole N37°E 41.09' Set pk and WCR disk #21566 in SE side
Util pole S10°E 123.23' Set nail and WCR tag in NE side
Elec pole S78°W 165.92' Set nail and WCR tag in North side
Elec pole N50°W 203.80' Set nail and WCR tag in SW side
Concrete Monument N47°E 60.00' (Offset monument)
Concrete Monument S47°W 60.00' (Offset monument)

Signed by Lawrence R. Feindt
Surveyor's Michigan License No. 21566
R LCR 7 4R 1PG U D.P.L.

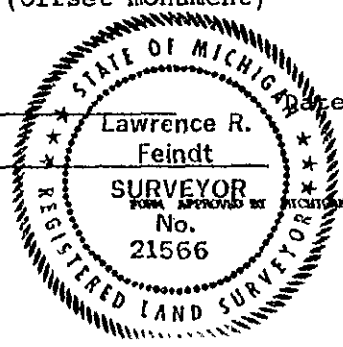

December 16, 1998

Grid table with columns A-M and rows 1-13. Contains numerical data and a central dot at row 10, column E.

\$4.00 REMONUMENTATION
\$7.00 DEED
RECORDED
FOREST E. YOUNGLOSO, REGISTER OF DEEDS
WAYNE COUNTY, MI
RECEIPT #101467