

APR 25 1995

COMMISSION

RC 1419

LAND CORNER RECORDATION CERTIFICATE  
Filing Requirement of Act 74, Mich. P.A. 1970

L127792PA276

For corners in

Wayne Located In: Corner Code G-4  
(County)

Dearborn Township #09

1. Public Land Survey T 2S R 10E \_\_\_\_\_  
T \_\_\_\_\_ R \_\_\_\_\_  
T \_\_\_\_\_ R \_\_\_\_\_  
T \_\_\_\_\_ R \_\_\_\_\_

2. Property Controlling S \_\_\_\_\_ T \_\_\_\_\_ R \_\_\_\_\_  
in Section S \_\_\_\_\_ T \_\_\_\_\_ R \_\_\_\_\_

3. Miscellaneous S \_\_\_\_\_ T \_\_\_\_\_ R \_\_\_\_\_  
Property in Sec. S \_\_\_\_\_ T \_\_\_\_\_ R \_\_\_\_\_

Compliance with  
ACT 345, P.A. 1990

APPROVED ON: 12/16/94 DRL  
WAYNE COUNTY REMONUMENTATION  
FEER GROUP COMMITTEE

Register of Deeds Stamp & File Number

4. Lot No. \_\_\_\_\_, Recorded Plat \_\_\_\_\_  
5. Private Claims \_\_\_\_\_

Lawrence R. Feindt, in a field survey on October 11, 19 94, do hereby certify that under requirements of P.A. 74, Michigan P.A. of 1970, the corner points mentioned in lines 1 and 2 above were in conformance with regulations and rules therelore as required in the current manual of survey instructions of the United States Department of the Interior, Bureau of Land Management or by a decree of a Court of Law and/or that the corner points mentioned in lines 3, 4 and 5 above were in conformance with the rules of the Michigan Board of Land Surveyors or by a Decree of a Court of Law; established, re-established, monumented, re-monumented, recovered, found as expressed below:

A	B	C	D	E	F	G	H	I	J	K	L	M
2	6	5	4	3	2	1						
3												
4	7	8	9	10	11	12						
5												
6	18	17	16	15	14	13						
7												
8	19	20	21	22	23	24						
9												
10	30	29	28	27	26	25						
11												
12	31	32	33	34	35	36						
13												

**NOTE: Not more than 4 corners, all in the same town and range, may be recorded on this certificate.**


A. Description of original monument and accessories and/or subsequent restoration:

G-4) 1/4 Corner Common to Sections 9 and 10, T 2 S, R 10 E  
GENERAL LAND OFFICE WAYNE COUNTY BUREAU OF TAXATION  
SET POST FOR CORNER NNE'LY-242.20'-30" HICKORY  
IRONWOOD 9"-S09 W-23 LINKS(15.18') ESE'LY-200.00'-26" HICKORY  
IRONWOOD 8"-N65 W-3 LINKS(1.98') SSE'LY-112.33'-28" OAK  
DECEMBER 27, 1816  
BY: JOSEPH FLETCHER, DS

\$ 13.00 MISCELLANEOUS RECORDING  
21 DEC 94 8:14 A.M. REGISTER # 1A  
FOREST E. VANDERKAM, REGISTER OF DEEDS

B. Description of corner evidence found and/or method applied in restoring or reestablishing corner:

G-4) 1/4 Corner Common to Sections 9 and 10, T 2 S, R 10 E  
Found concrete monument in hedge row on West line of "University Campus Sub'n." as recorded in Liber 81, Page 9, Wayne County records, and on the East line of "Supervisor's Dearborn Plat No. 2" as recorded in Liber 65 of Plats, Page 50, Wayne County records.

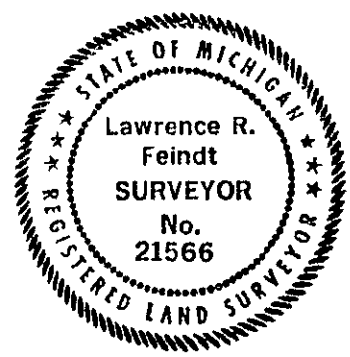

C. Description of monument for corner and accessories established to perpetuate locating the position of the corner:

G-4) 1/4 Corner Common to Sections 9 and 10, T 2 S, R 10 E  
Found concrete monument in hedge row and placed Wayne County brass disk stamped with license #21566. Corner is accepted as a careful and faithful reestablishment of the position of the original corner.

Witnesses: N87°E - 5.74' - Set Pk nail in NW face of utility pole  
N79°W - 25.21' - Set PK nail in NE face of 14" Maple  
N11°E - 45.36' - Set nail and WCR cap in E'ly face of power pole  
S02°E - 33.11' - Set Pk nail in E'ly face of 28" Oak  
N05°E - 325.53' - Found concrete monument in monument box / PC center line of Ann Arbor Trail

2R  
11 D-MISC

Signed by Lawrence R. Feindt Date 12/21/94  
Surveyor's Michigan License No. 21566