

RECORDED

RC 1155

FEB 28 1994

COMMISSION

LAND CORNER RECORDATION CERTIFICATE
Filing Requirement of Act 74, Mich. P.A. 1970


1126992 PA 839

For corners in

Table with columns: Wayne (County), Located In: (T 2N R 10E), Corner Code # (K-5). Includes items 1-5: Public Land Survey, Property Controlling in Section, Miscellaneous Property in Sec., Lot No., Private Claims.

Compliance with ACT 345, P.A. 1990
APPROVED ON: 11-30-93
WAYNE COUNTY REMONUMENTATION PEER GROUP COMMITTEE
Register of Deeds Stamp & File Number

I, Lawrence R. Feindt, in a field survey on November 5, 1993, do hereby certify that under requirements of P.A. 74, Michigan P.A. of 1970, the corner points mentioned in lines 1 and 2 above were in conformance with regulations and rules therefore as required in the current manual of survey instructions of the United States Department of the Interior, Bureau of Land Management or by a decree of a Court of Law and/or that the corner points mentioned in lines 3, 4 and 5 above were in conformance with the rules of the Michigan Board of Land Surveyors or by a Decree of a Court of Law; established, re-established, monumented, re-monumented, recovered, found as expressed below:

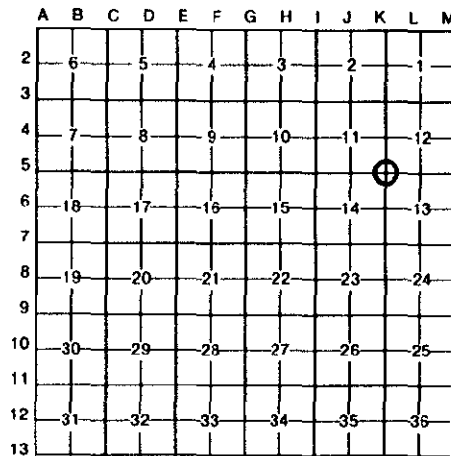


NOTE: Not more than 4 corners, all in the same town and range, may be recorded on this certificate.

A. Description of original monument and accessories and/or subsequent restoration:

K-5) Corner Common to Sections 11, 12, 13 & 14, T 2 S, R 10 E
GENERAL LAND OFFICE M.D.O.T. FOUND 3/4" BRASS PLUG
SET POST FOR CORNER SET 1" BRASS PLUG IN BRIDGE DECK N48 W- 60.71'-CUT CROSS IN
BEECH 16"-S79 W-18 LINKS(11.88') N55 W- 4.99'-CHISELED X IN STEEL CONCRETE ISLAND
W. ASH 10"-N28 30'E-38 LINKS(25.08') EXPANSION PLATE N48 E- 60.08'-CUT CROSS IN
DECEMBER 19, 1816 S85 W- 68.95'-DRILL HOLE IN SQUARE CONCRETE ISLAND
BY: JOSEPH FLETCHER, DS SE COR. LIGHT POLE S77 E- 48.21'-BASE OF STEEL LIGHT POLE
S60 E- 48.78'-DRILL HOLE IN SQUARE S81 W- 68.38'-BASE OF STEEL LIGHT POLE
SW COR. LIGHT POLE APRIL 24, 1973
MARCH 8, 1964 BY: TERENCE B. CANTRELL, PS #5782
BY: BERNARD J. SWIEBODA, SURVEY CHIEF RECORDED IN LIBER 18415, PAGE 337, MCR

B. Description of corner evidence found and/or method applied in restoring or reestablishing corner:

K-5) Corner Common to Sections 11, 12, 13 & 14, T 2 S, R 10 E
Found 1" brass plug in bridge deck as documented by the Michigan Department of Transportation in 1964. Confirmed the mathematical relationships of K-5 with K-4, M-4 and L-5 employing measurements by Orchard, Hiltz & McCliment, Inc. as denoted on maps prepared for Ford Motor Land Development on April 16, 1986 (Job No.: 248-85-020). Former witnesses by M.D.O.T. and Terence Cantrell were obliterated.

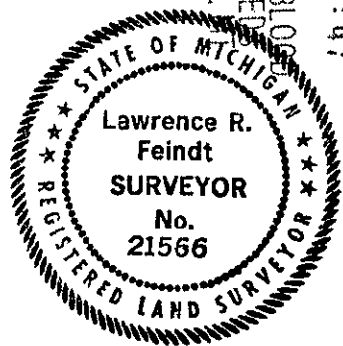

C. Description of monument for corner and accessories established to perpetuate locating the position of the corner:

K-5) Corner Common to Sections 11, 12, 13 & 14, T 2 S, R 10 E
Found 1" brass plug in East bound Ford Road bridge overpass over M-39 (Southfield Freeway) and is accepted as a careful and faithful reestablishment of the position of the original corner.
Witnesses: South - 0.10' - Set "T"-iron 6" long in concrete bridge deck
West - 4.17' - Steel expansion joint crack
South - 12.60' - Face of curb
South - 22.22' - Set PK nail in Wayne County brass disk stamped with license #21566 in North face of concrete wall 1.4' above walk
S47 E - 31.97' - Set PK nail in concrete walk 0.5' North of North face of concrete wall

Signed by Lawrence R. Feindt Date November 29, 1993
Surveyor's Michigan License No. 21566