

FEB 28 1994

RC 1248

LI 27015 PA 724

LAND CORNER RECORDATION CERTIFICATE
Filing Requirement of Act 74, Mich. P.A. 1970

For corners in

Wayne (County) Located In: Corner Code #

1. Public Land Survey T 3 S R 8 E. A-6
 T R
 T R
 T R

2. Property Controlling S T R
 in Section S T R
 3. Miscellaneous S T R
 Property in Sec. S T R

4. Lot No. , Recorded Plat
 5. Private Claims

Compliance with ACT 345, P.A. 1990
APPROVED ON: 12-7-93
WAYNE COUNTY REMONUMENTATION PEER GROUP COMMITTEE

Register of Deeds Stamp & File Number

	A	B	C	D	E	F	G	H	I	J	K	L	M
2	6	5	4	3	2	1							
3													
4	7	8	9	10	11	12							
5													
6	18	17	16	15	14	13							
7													
8	19	20	21	22	23	24							
9													
10	30	29	28	27	26	25							
11													
12	31	32	33	34	35	36							
13													

I, William L. Roskelly in a field survey on _____, 19 93 do hereby certify that under requirements of P.A. 74, Michigan P.A. of 1970, the corner points mentioned in lines 1 and 2 above were in conformance with regulations and rules therefore as required in the current manual of survey instructions of the United States Department of the Interior, Bureau of Land Management or by a decree of a Court of Law and/or that the corner points mentioned in lines 3, 4 and 5 above were in conformance with the rules of the Michigan Board of Land Surveyors or by a Decree of a Court of Law; established, re-established, monumented, re-monumented, recovered, found as expressed below:

NOTE: Not more than 4 corners, all in the same town and range, may be recorded on this certificate.

A. Description of original monument and accessories and/or subsequent restoration:

No G.L.O. Witnesses remain

B. Description of corner evidence found and/or method applied in restoring or reestablishing corner:


Concrete monument with iron pipe at fence corner.

Found PK nail N.W. face 6" Elm N. 30° E. dist. 8.55 meas. 8.60 see #1 below
 Found PK nail N.W. face 6" Cherry N. 60° E. dist. 13.79± meas. 14.05 see #2 below
 Found iron pipe due South on fence line dist. 97.88 meas. 97.95 point being used as E. 1/4 corner Section 13, T.3 S.R.7 E.

C. Description of monument for corner and accessories established to perpetuate locating the position of the corner:

A-6: Section corner 18, T.3 S.R.8 E. Found concrete mon. with iron pipe. The selected location is accepted by the Contractor and is generally accepted by professional surveyors as the best available evidence of the position of the original corner. Placed Wayne Co. brass disk with license #10705.
 Set WCR Tag West face 9" Elm N. 30° E. dist. 8.40
 Set WCR Tag Southerly face 8" Cherry N. 60° E. dist. 13.96
 Set WCR Tag Northerly face 10" Poplar S. 70° E. dist. 24.07
 Found iron pipe due South on fence line dist. 97.95
 Set WCR Tag Northerly face 8" Ash N. 70° W. dist. 39.67

Signed by William L. Roskelly Date November 9, 1993
 Surveyor's Michigan License No. 10705

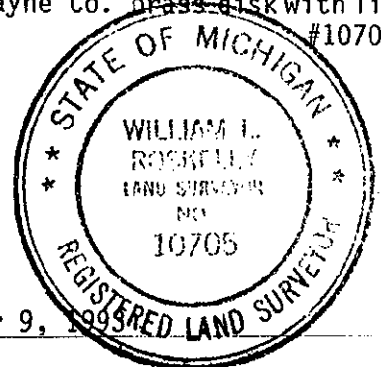

22 11KT