

SURVEY & REMONUMENTATION

RC 1568

\$ 13.00 MISCELLANEOUS RECORDING
28 DEC 94 8:21 A.M. RECEIPT# 129

APR 25 1995

LAND CORNER RECORDATION CERTIFICATE
Filing Requirement of Act 74, Mich. P.A. 1970

RECORDED
FOREST E. YOUNG, REGISTER OF DEEDS
WAYNE COUNTY, MI

For corners in **COMMISSION**

Wayne <small>(County)</small>	Located In:	Corner Code -#
1. Public Land Survey	T <u>3</u> S R <u>8</u> E	<u>B-3</u>
	T _____ R _____	_____
	T _____ R _____	_____
	T _____ R _____	_____
2. Property Controlling in Section	S _____ T _____ R _____	<u>Seg. 1</u>
	S _____ T _____ R _____	_____
3. Miscellaneous Property in Sec.	S _____ T _____ R _____	_____
	S _____ T _____ R _____	_____

L127800PA060

SEQUENCE # 1

Compliance with ACT 345, P.A. 1990

APPROVED ON: 12-8-94 *DPJ*
WAYNE COUNTY REMONUMENTATION
PEER GROUP COMMITTEE

Register of Deeds Stamp & File Number

RC 1568

4. Lot No. _____, Recorded Plat _____
5. Private Claims _____

A	B	C	D	E	F	G	H	I	J	K	L	M
2	6	5	4	3	2	1						
3	7	8	9	10	11	12						
4												
5												
6	18	17	16	15	14	13						
7												
8	19	20	21	22	23	24						
9												
10	30	29	28	27	26	25						
11												
12	31	32	33	34	35	36						
13												

I, William L. Roskelly in a field survey on November 1, 1994, do hereby certify that under requirements of P.A. 74, Michigan P.A. of 1970, the corner points mentioned in lines 1 and 2 above were in conformance with regulations and rules therefore as required in the current manual of survey instructions of the United States Department of the Interior, Bureau of Land Management or by a decree of a Court of Law and/or that the corner points mentioned in lines 3, 4 and 5 above were in conformance with the rules of the Michigan Board of Land Surveyors or by a Decree of a Court of Law; established, re-established, monumented, re-monumented, recovered, found as expressed below:

NOTE: Not more than 4 corners, all in the same town and range, may be recorded on this certificate.

A. Description of original monument and accessories and/or subsequent restoration:

B-3) South Corner Common to Sections 6 & 7, T.3 S., R.8 E.

G.L.O. (1830's) J. Wampler set post witnesses Elm 11S 10W 12 (gone) Sugar 9N 12W 18 (gone)
W.P.A. (1930's) found an iron and witnesses N.W. 89.10 18" Maple (gone),
S.W. 69.22 20" Maple (gone), N. 35.72 6" Locust (gone), N.E. 72.20 20" Apple (gone),
S.E. 3383 Telephone pole (gone), S. 31.21 36" Maple (gone)
No C.S.'s or R.C.'s on file at Wayne County Reg. of Deeds.

B. Description of corner evidence found and/or method applied in restoring or reestablishing corner:

B-3) South Corner Common to Sections 6 & 7, T.3 S., R.8 E.

Found a 1" steel bar in centerline of Ecorse Road asphalt. Compared field measurements with W.P.A. survey.


B-3 to C-3 W.P.A. = 2690.04 Measured 2689.85
C-3 to C-2 W.P.A. = 2668.52 Measured 2668.68
Line C-3 to B-3 to line C-3 to C-2 W.P.A. = 89° 44' 10" Measured 89° 44' 03"

C. Description of monument for corner and accessories established to perpetuate locating the position of the corner:

B-3) South Corner Common to Section 6 & 7, T.3 S., R.8 E.

Found a 1" steel bar in centerline of Ecorse Road asphalt.
The selected location is accepted by the Contractor and is generally accepted by professional surveyors as the best available evidence of the position of the original corner.
Top bolt of hydrant N.52° E, Dist. = 67.31
Set steel bar S.22° E, Dist. = 50.21
Set nail W.C.R. tag East face 15" Maple N.22° W., Dist. = 28.94
Placed Wayne County Remonumentation brass marker and cap # 10705
Set nail W.C.R. tag S. face 24" Maple cluster N.71° W. Dist. = 76.07.

Signed by William L. Roskelly Date 12/27/94
Surveyor's Michigan License No. 10705

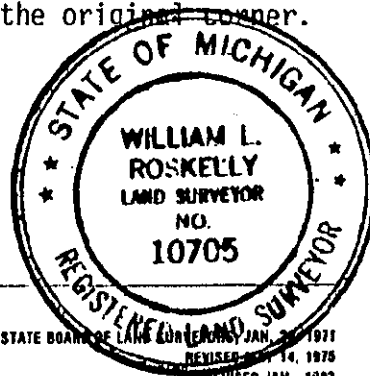

ZR
11-D
MISC