

SURVEY & REMONUMENTATION

RC 1570

\$ 16.00 MISCELLANEOUS RECORDING
28 DEC 94 8:22 A.M. RECEIPT# 100

APR 25 1995

LAND CORNER RECORDATION CERTIFICATE
Filing Requirement of Act 74, Mich. P.A. 1970

COMMISSION

LI27800PA062

SEQUENCE #1

Compliance with
ACT 345, P.A. 1990

APPROVED ON: 12-8-94 *DBJ*
WAYNE COUNTY REMONUMENTATION
PEER GROUP COMMITTEE

Register of Deeds Stamp & File Number

RC 1570

Wayne (County)	Located In:	Corner Code #
1. Public Land Survey	T 3 S R 8 E	C-2
	T R	
	T R	
	T R	
	T R	
2. Property Controlling in Section	S T R	<i>Seq. 1</i>
	S T R	
3. Miscellaneous Property in Sec.	S T R	<i>Pg. 1 of 2</i>
	S T R	

4. Lot No. _____, Recorded Plat _____
5. Private Claims _____

	A	B	C	D	E	F	G	H	I	J	K	L	M
2	6	5	4	3	2	1							
3													
4	7	8	9	10	11	12							
5													
6	18	17	16	15	14	13							
7													
8	19	20	21	22	23	24							
9													
10	30	29	28	27	26	25							
11													
12	31	32	33	34	35	36							

William L Roskelly, in a field survey on October 1, 19 94, do hereby certify that under requirements of P.A. 74, Michigan P.A. of 1970, the corner points mentioned in lines 1 and 2 above were in conformance with regulations and rules therefore as required in the current manual of survey instructions of the United States Department of the Interior, Bureau of Land Management or by a decree of a Court of Law and/or that the corner points mentioned in lines 3, 4 and 5 above were in conformance with the rules of the Michigan Board of Land Surveyors or by a Decree of a Court of Law; established, re-established, monumented, re-monumented, recovered, found as expressed below:

NOTE: Not more than 4 corners, all in the same town and range, may be recorded on this certificate.

A. Description of original monument and accessories and/or subsequent restoration:

C-2) Section Corner East Section 6, T.3 S.,R.8 E.
G.L.O. (1830's) J. Wampler, post is a Beech 23" in diameter, no corner set.
W.P.A. (1930's) set a monument and witnesses:
N.W. 34.95 14" Maple (gone) S.E. 49.25 to centerline W. bound R.R. track (measured 49.25)
N.W. 53.97 14" Elm (gone) S.E. 35.30 Telephone pole (gone)
S.W. 35.09 cor. conc. batt. box (gone) N.E. 44.23 24" Maple stump (gone)
(continued to page 2)

B. Description of corner evidence found and/or method applied in restoring or reestablishing corner:


C-2) Section Corner East Section 6, T.3 S.,R.8 E.
Found a 1" iron pipe at the centerline of Denton Road asphalt. Compared field measurements with W.P.A. survey.
C-2 to C-3 W.P.A. = 2668.52 Measured = 2668.68
C-3 to B-3 W.P.A. = 2690.04 Measured = 2689.85
Line C-3 to B3 angle to line C-3 to C-2 W.P.A. 89° 44' 10" Measured 89° 44' 03"
Corner also checked to W.P.A. witness record = 49.25, Measured 49.25

C. Description of monument for corner and accessories established to perpetuate locating the position of the corner:

C-2) Section Corner East Section 6, T.3 S.,R.8 E.
Found a 1" iron pipe at the centerline of Denton Road asphalt. The selected location is accepted by the Contractor and is generally accepted by professional surveyors as the best available evidence of the position of the original corner. Found nail and tag OHM KSW #21584 N. face P. pole N.80° E. dist. 29.24
Found cross cut N.E. bolt R.R. signal S.13° E. dist.=78.63
Found cross cut S.E. bolt R.R. signal S.30° W. dist.=43.73
Set nail & W.C.R. tag South face P. pole N.60° W. dist.=25.16
Placed Wayne County Remonumentation brass marker with #10705 stamped.

*2E
14-D
misc.*

Signed by *William L Roskelly* Date 12/27/94
Surveyor's Michigan License No. 10705

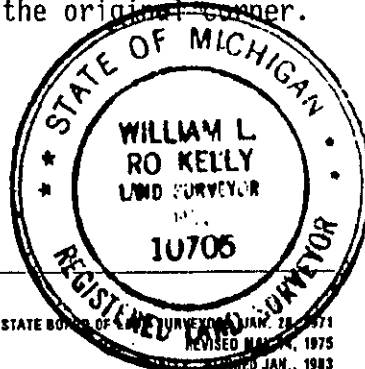

LAND CORNER RECORDATION CERTIFICATE
Filing Requirement of Act 74, Mich. P.A. 1970

LI27800PA063

Compliance with
 ACT 345, P.A. 1990

APPROVED ON: 12-8-94 *WJL*
 WAYNE COUNTY REMONUMENTATION
 PEER GROUP COMMITTEE

Register of Deeds Stamp & File Number

For corners in

Wayne (County) Located In: Corner Code #C-2

1. Public Land Survey	T <u>3</u> S R <u>8</u> E	<u>C-2</u>
	T _____ R _____	_____
	T _____ R _____	_____
	T _____ R _____	_____
2. Property Controlling In Section	S _____ T _____ R _____	<u>Seg. 1</u>
	S _____ T _____ R _____	_____
3. Miscellaneous Property in Sec.	S _____ T _____ R _____	<u>Pg 2 of 2</u>
	S _____ T _____ R _____	_____

4. Lot No. _____, Recorded Plat _____
 5. Private Claims _____

I, _____, in a field survey on _____, 19____, do hereby certify that under requirements of P.A. 74, Michigan P.A. of 1970, the corner points mentioned in lines 1 and 2 above were in conformance with regulations and rules therefore as required in the current manual of survey instructions of the United States Department of the Interior, Bureau of Land Management or by a decree of a Court of Law and/or that the corner points mentioned in lines 3, 4 and 5 above were in conformance with the rules of the Michigan Board of Land Surveyors or by a Decree of a Court of Law; established, re-established, monumented, re-monumented, recovered, found as expressed below:

NOTE: Not more than 4 corners, all in the same town and range, may be recorded on this certificate.


	A	B	C	D	E	F	G	H	I	J	K	L	M
2	6	●	5		4		3		2		1		
3													
4	7		8		9		10		11		12		
5													
6	18		17		16		15		14		13		
7													
8	19		20		21		22		23		24		
9													
10	30		29		28		27		26		25		
11													
12	31		32		33		34		35		36		
13													

A. Description of original monument and accessories and/or subsequent restoration:
 (continued from page 1)

Wayne County Road Commission 6/4/70 E. Johns Witnesses:
 N.W. 37.78' M.B.T. pole (gone)
 S.W. 20.53 N.E. bolt base of R.R. signal (gone)
 S.E. 35.43 M.B.T. pole 35.43 (gone)
 C.S. #2073 L. 26370, P. 518 4-19-79 Allen R. Rentschler.
 No witnesses or corner description.

B. Description of corner evidence found and/or method applied in restoring or reestablishing corner:

C. Description of monument for corner and accessories established to perpetuate locating the position of the corner:

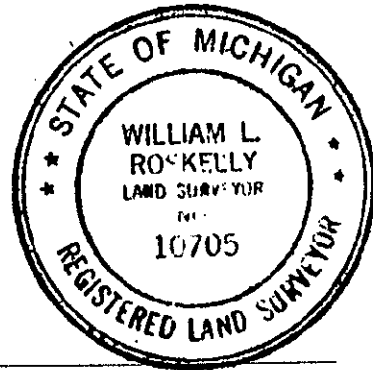

Signed by *William L. Rock Kelly* Date 12/27/94
 Surveyor's Michigan License No. 10705