

FEB 28 1994

LAND CORNER RECORDATION CERTIFICATE  
Filing Requirement of Act 74, Mich. P.A. 1970

LI 27015 PA 727

For corners in COMMISSION  
Wayne  
(County)

Located In: Corner Code ##

- 1. Public Land Survey T 3 S R 8 E. C-11  
T \_\_\_\_\_ R \_\_\_\_\_  
T \_\_\_\_\_ R \_\_\_\_\_  
T \_\_\_\_\_ R \_\_\_\_\_
- 2. Property Controlling S \_\_\_\_\_ T \_\_\_\_\_ R \_\_\_\_\_  
in Section S \_\_\_\_\_ T \_\_\_\_\_ R \_\_\_\_\_
- 3. Miscellaneous S \_\_\_\_\_ T \_\_\_\_\_ R \_\_\_\_\_  
Property in Sec. S \_\_\_\_\_ T \_\_\_\_\_ R \_\_\_\_\_

Compliance with  
ACT 345, P.A. 1990  
APPROVED ON: 12-7-93 *DRJ*  
WAYNE COUNTY REMONUMENTATION  
PEER GROUP COMMITTEE

Register of Deeds Stamp & File Number

- 4. Lot No. \_\_\_\_\_, Recorded Plat \_\_\_\_\_
- 5. Private Claims \_\_\_\_\_

	A	B	C	D	E	F	G	H	I	J	K	L	M
2	6	5	4	3	2	1							
3													
4	7	8	9	10	11	12							
5													
6	18	17	16	15	14	13							
7													
8	19	20	21	22	23	24							
9													
10	30	29	28	27	26	25							
11													
12	31	32	33	34	35	36							
13													

I, William L. Roskelly in a field survey on November 3, 19 93, do hereby certify that under requirements of P.A. 74, Michigan P.A. of 1970, the corner points mentioned in lines 1 and 2 above were in conformance with regulations and rules therefore as required in the current manual of survey instructions of the United States Department of the Interior, Bureau of Land Management or by a decree of a Court of Law and/or that the corner points mentioned in lines 3, 4 and 5 above were in conformance with the rules of the Michigan Board of Land Surveyors or by a Decree of a Court of Law; established, re-established, monumented, re-monumented, recovered, found as expressed below:

**NOTE: Not more than 4 corners, all in the same town and range, may be recorded on this certificate.**

A. Description of original monument and accessories and/or subsequent restoration:


No G.L.O. Witnesses remain. J. Wampler G.L.O. (1819) set corner. Witnesses: Ash 4S25 W4 WO 40 N30 W L.C.R.C. L. 24962, P. 741 on 1/3/93 Michael Hoben found a 1/2" iron pipe at Hoeft & Hull Roads and recorded the following witnesses:  
N. 60° W. 53.16 c/1 T. Bolt of F. Hyd.  
N. 30° W. 53.93 O.H.M. tag N.E. face P.P.  
N. 75° E. 86.64 O.H.M. tag S. face P.P.  
S. 40° W. 55.73 T.N.E. co. gas box

B. Description of corner evidence found and/or method applied in restoring or reestablishing corner:

Found 1 1/2" iron pipe at intersection Hoeft & Hull dirt roads  
Verified section corner location thru recorded document RC 989 - L. 24962, Pg. 741  
N. 60° W. 53.16 meas. 53.03 #4 below  
N. 30° W. 53.93 meas. 53.74 #5 below  
N. 75° E. 86.64 meas. 86.71 #1 below  
S. 40° W. 55.73 meas. 55.55 #3 below

C. Description of monument for corner and accessories established to perpetuate locating the position of the corner:

C-11" Section corner 29, 30, 31 & 32 T.3 S.R.8 E. found 1 1/2" iron pipe. The selected location is accepted by the Contractor and is generally accepted by professional surveyors as the best available evidence of the position of the original corner. Placed Wayne Co. brass disk with license #10705.  
Found Tag OHM #21584 south face P. pole N. 75° E. dist. 86.71  
Found steel bar S. 45° E. dist. 46.81  
Found gas box used NE corner rim S. 40° W. dist. 55.55  
Top bolt hydrant N. 60° W. dist. 53.03  
Found tag OHM #21584 NE face P. Pole N. 30° W. dist. 53.74

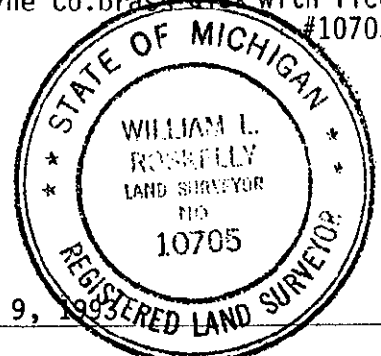

Signed by William L. Roskelly  
Surveyor's Michigan License No. 10705

Date November 9, 1993

*DRJ* *HKD*

RC 1251

RECORDED - 7 PM 011