

LAND CORNER RECORDATION CERTIFICATE
Filing Requirement of Act 74, Mich. P.A. 1970

LI 27015 PA 728

FEB 28 1994

For corners in

Wayne

(County)

REMONUMENTATION Located In:

Corner Code #

- 1. Public Land Survey T 3 S R 8 E. C-12
T _____ R _____
T _____ R _____
T _____ R _____
- 2. Property Controlling S _____ T _____ R _____
in Section S _____ T _____ R _____
- 3. Miscellaneous S _____ T _____ R _____
Property in Sec. S _____ T _____ R _____

Compliance with
ACT 345, P.A. 1990

APPROVED ON: 12-7-93
WAYNE COUNTY REMONUMENTATION
PEER GROUP COMMITTEE

Register of Deeds Stamp & File Number

- 4. Lot No. _____, Recorded Plat _____
- 5. Private Claims _____

I, William L. Roskelly in a field survey on November 2, 19 93, do hereby certify that under requirements of P.A. 74, Michigan P.A. of 1970, the corner points mentioned in lines 1 and 2 above were in conformance with regulations and rules therefore as required in the current manual of survey instructions of the United States Department of the Interior, Bureau of Land Management or by a decree of a Court of Law and/or that the corner points mentioned in lines 3, 4 and 5 above were in conformance with the rules of the Michigan Board of Land Surveyors or by a Decree of a Court of Law; established, re-established, monumented, re-monumented, recovered, found as expressed below:

	A	B	C	D	E	F	G	H	I	J	K	L	M
2	6		5		4		3		2		1		
3													
4	7		8		9		10		11		12		
5													
6	18		17		16		15		14		13		
7													
8	19		20		21		22		23		24		
9													
10	30		29		28		27		26		25		
11													
12	31		32		33		34		35		36		
13													

NOTE: Not more than 4 corners, all in the same town and range, may be recorded on this certificate.

A. Description of original monument and accessories and/or subsequent restoration:


No G.L.O. Witnesses remain.
L.C.R.C. L. 21166, Pg. 823 on 6/8/81 Thomas Gilmore found a 3/4" pipe and recorded the following witnesses:
Spike N.E. side 12" Maple N. 25° W. 82.00'
Spike N.W. side 16" Cherry N. 25° E. 76.03'
Spike S.W. side 36" Oak S. 55° E. 42.16'

B. Description of corner evidence found and/or method applied in restoring or reestablishing corner:

Found 3/4" iron pipe with P.K. nail at Martz and Hoeft Roads. Dirt
Verified section corner thru witness document RC 773 L. 21166, Pg. 823
N. 25° W. same tree as 6 below. Could not find original spike check to tree ±
N. 25° E. P.K. nail spike N.W. side 16" Cherry recorded 76.03 meas. 76.08 same tree as #1

C. Description of monument for corner and accessories established to perpetuate locating the position of the corner:
C-12: Section corner 31 & 32 Found a 3/4" iron pipe with P.K. nail at Martz & Hoeft Roads. The selected location is accepted by the Contractor and is generally accepted by professional surveyors as the best available evidence of the position of the original corner. Placed Wayne Co. brass disk with license #10705.

- Found P.K. tag OHM #21584 W. face 24" Cherry N. 30° E. dist. 75.83
- Top bolt hydrant N. 80° E. dist. 67.82
- Set WCR Tag N.W. face 38" Oak S. 40° E. dist. 41.30
- Also found P.K. nail N.W. face 38" Oak S. 40° E. dist. 41.00
- Found P.K. Tag OHM #21584 NW face Guy pole S. 50° W. dist. 32.68
- Found WCR Tag S.W. face P. pole N. 26° W. dist. 35.37
- Set WCR Tag Eastface 24" Maple N. 36° W. dist. 80.47
- Found conc. monument N. 40° W. dist. 74.25

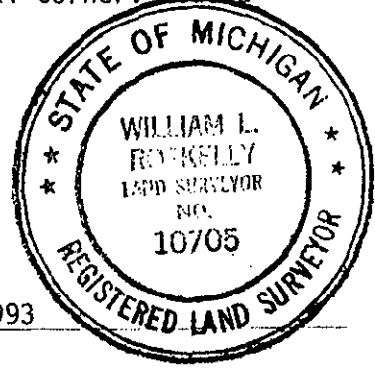

Signed by William L. Roskelly Date November 9, 1993

Surveyor's Michigan License No. 10705

2R 11KD