

FEB 28 1994

LAND CORNER RECORDATION CERTIFICATE 27015 PA 729  
Filing Requirement of Act 74, Mich. P.A. 1970

For corners in COMMISSION  
Wayne  
(County)

	Located In:	Corner Code #
1. Public Land Survey	T <u>3</u> S <u>8</u> E.	<u>G-3</u>
	T _____ R _____	_____
	T _____ R _____	_____
	T _____ R _____	_____
2. Property Controlling in Section	S _____ T _____ R _____	_____
	S _____ T _____ R _____	_____
3. Miscellaneous Property in Sec.	S _____ T _____ R _____	_____
	S _____ T _____ R _____	_____

Compliance with ACT 345, P.A. 1990  
APPROVED ON: 12-7-93 *JKL*  
WAYNE COUNTY REMONUMENTATION PEER GROUP COMMITTEE

Register of Deeds Stamp & File Number

4. Lot No. \_\_\_\_\_, Recorded Plat \_\_\_\_\_  
5. Private Claims \_\_\_\_\_

	A	B	C	D	E	F	G	H	I	J	K	L
2	6		5		4		3		2		1	
3							●					
4	7		8		9		10		11		12	
5												
6	18		17		16		15		14		13	
7												
8	19		20		21		22		23		24	
9												
10	30		29		28		27		26		25	
11												
12	31		32		33		34		35		36	
13												

William L. Roskelly in a field survey on October 29, 19 93, do hereby certify that under requirements of P.A. 74, Michigan P.A. of 1970, the corner points mentioned in lines 1 and 2 above were in conformance with regulations and rules therefore as required in the current manual of survey instructions of the United States Department of the Interior, Bureau of Land Management or by a decree of a Court of Law and/or that the corner points mentioned in lines 3, 4 and 5 above were in conformance with the rules of the Michigan Board of Land Surveyors or by a Decree of a Court of Law; established, re-established, monumented, re-monumented, recovered, found as expressed below:

NOTE: Not more than 4 corners, all in the same town and range, may be recorded on this certificate.

A. Description of original monument and accessories and/or subsequent restoration:


No G.L.O. Witnesses remain

J. Wampler G.L.O. (1819) set corner Witnesses: BO 44S67 W8 Aspen 10 N26 W46

B. Description of corner evidence found and/or method applied in restoring or reestablishing corner:

Found monument box with conc. mon. steel bar

Verified corner position using W.P.A. map. Distance G:3 to H:3 2687.86 records, 2688.06 measured. Distance G:3 to G:4 2676.62 recorded, 2677.08 measured. Angle G:3-H:3 to G:3-G:4 recorded 90° 28' 20", measured 90° 27' 40".

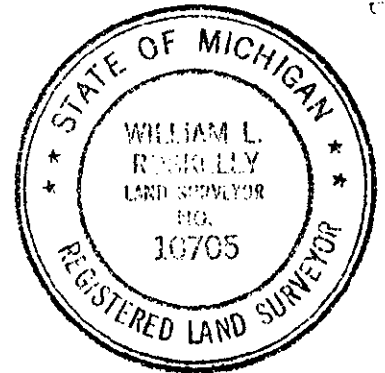

C. Description of monument for corner and accessories established to perpetuate locating the position of the corner:

G-3: Section corner 3,4,9 & 10 T.3 S.R.8 E. found monument box with conc. mon. steel bar  
The selected location is accepted by the Contractor and is generally accepted by professional surveyors as the best available evidence of the position of the original corner. Placed Wayne Co. brass disk with license #10705.  
Found WCRC Tag & PK South face P. Pole N. 50° E. dist. 72.81  
Set PK & Tag 10705 c/l old Ecorse Road due East dist. 62.07  
N.W. corner of Catch Basin Rim S. 40° E. dist. 44.15  
N.E. corner of Catch Basin rim S. 50° W. dist. 45.65  
Set PK & Tag 10705 c/l old Ecorse Road due West dist. 63.47

Signed by William L. Roskelly Date November 9, 1993  
Surveyor's Michigan License No. 10705

*JKL*