

LAND CORNER RECORDATION CERTIFICATE
Filing Requirement of Act 74, Mich. P.A. 1970

FEB 28 1994

For corners in

Wayne	COMMISSION	Located In:	Corner Code #
(County)			
1. Public Land Survey	T 3 S R 8 E.	G-5	
	T _____ R _____		
	T _____ R _____		
	T _____ R _____		
2. Property Controlling in Section	S _____ T _____ R _____		
	S _____ T _____ R _____		
3. Miscellaneous Property in Sec.	S _____ T _____ R _____		
	S _____ T _____ R _____		
4. Lot No. _____, Recorded Plat _____			
5. Private Claims _____			

Compliance with
ACT 345, P.A. 1990

APPROVED ON: 12-7-93 *[Signature]*
WAYNE COUNTY REMONUMENTATION
PEER GROUP COMMITTEE

Register of Deeds Stamp & File Number

I, William L. Roskelly in a field survey on October 29, 19 93, do hereby certify that under requirements of P.A. 74, Michigan P.A. of 1970, the corner points mentioned in lines 1 and 2 above were in conformance with regulations and rules therefore as required in the current manual of survey instructions of the United States Department of the Interior, Bureau of Land Management or by a decree of a Court of Law and/or that the corner points mentioned in lines 3, 4 and 5 above were in conformance with the rules of the Michigan Board of Land Surveyors or by a Decree of a Court of Law; established, re-established, monumented, re-monumented, recovered, found as expressed below:

NOTE: Not more than 4 corners, all in the same town and range, may be recorded on this certificate.


A	B	C	D	E	F	G	H	I	J	K	L	M
2	6	5	4	3	2	1						
3												
4	7	8	9	10	11	12						
5												
6	18	17	16	15	14	13						
7												
8	19	20	21	22	23	24						
9												
10	30	29	28	27	26	25						
11												
12	31	32	33	34	35	36						
13												

A. Description of original monument and accessories and/or subsequent restoration: No G.L.O. Witnesses remain.

J. Wamplet G.L.O.(1819) set corner. Witnesses: W08 S73 E25 B.o 12 N68 W25
L.C.R.C. L. 20027 P. 888 & 889 on 1/30/78 R. W. Swanson found a con. mon. in mon. box and recorded the following witnesses:
N.W. 83.45 ft. to spike with brass tag in S.W. side of Mich. Bell pole.
N.E. 70.89 " " "X" cut in S.W. corner of concrete base of traffic signal control.
S.E. 78.46 " " spike with brass tag in S.W. side of Detroit Edison pole.
S.W. 70.81 " " " " " " " " N.W. " " Mich. Bell pole.
W-S.W. 57.04 " " " " " " " " N.W. " " Detroit Edison pole.

B. Description of corner evidence found and/or method applied in restoring or reestablishing corner:

Found monument box con. mon. cap iron #17089
Verified section corner thru recorded document RC 575 L. 20027, PG. 888 & 889
N. 60° E. "x" cut 70.89 meas. 70.85 #2 below
S. 40° E. Tag 78.46 meas. 78.25 #3 below
S. 34° W. Tag in pole 57.04 meas. 57.15

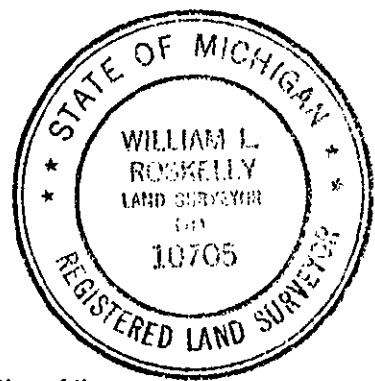

C. Description of monument for corner and accessories established to perpetuate locating the position of the corner:

G-5: Section corner 9,10,15 & 16 T.3 S.R.8 E. Found monument box conc. mon. with capped iron #17
The selected location is accepted by the Contractor and is generally accepted by professional surveyors as the best available evidence of the position of the original corner. Placed Wayne Co. brass disk with license #10705.
Set WCR Tag N.W. face guy pole N. 50° E. dist. 72.00
Found "x" cut in S.W. corner. fo con. base traffic signal N. 60° E. dist. 70.85
Found spike with tag in SE side P. pole S. 40° E. dist. 78.25
Found spike with tag in NW face P. pole S. 34° W. dist. 57.15
Set WCR Tag N.E. face P. pole N. 30° W. dist. 70.80

Signed by *William L. Roskelly* Date November 9, 1993
Surveyor's Michigan License No. 10705