

FEB 28 1994

LAND CORNER RECORDATION CERTIFICATE
Filing Requirement of Act 74, Mich. P.A. 1970

For corners in COMMISSION

Table with columns: WAYNE COUNTY (County), Located In:, Corner Code =#. Rows include Public Land Survey, Property Controlling in Section, and Miscellaneous Property in Sec.

Compliance with ACT 345, P.A. 1990
APPROVED ON: 12-21-93
WAYNE COUNTY REMONUMENTATION PEER GROUP COMMITTEE

Register of Deeds Stamp & File Number

4. Lot No. , Recorded Plat
5. Private Claims

I, RAPHAEL LANDINI, in a field survey on NOVEMBER 23, 19 93, do hereby certify that under requirements of P.A. 74, Michigan P.A. of 1970, the corner points mentioned in lines 1 and 2 above were in conformance with regulations and rules therefore as required in the current manual of survey instructions of the United States Department of the Interior, Bureau of Land Management or by a decree of a Court of Law and/or that the corner points mentioned in lines 3, 4 and 5 above were in conformance with the rules of the Michigan Board of Land Surveyors or by a Decree of a Court of Law; established, re-established, monumented, re-monumented, recovered, found as expressed below:

NOTE: Not more than 4 corners, all in the same town and range, may be recorded on this certificate.

Grid table with columns A-M and rows 2-13. A black dot is located at the intersection of column G and row 6.

A. Description of original monument and accessories and/or subsequent restoration:

- G.L.O.
BEECH 9 N33W 19 (12.5) (GONE)
ELM 17 S88E 20 (13.2) (GONE)
WPA 1930S IRON POLE E 25.00 (GONE)
8" ELM SE 75.86 (GONE)
USGS MARK SW 58.48 (GONE)
20" HICKORY NW 118.15 (GONE)


B. Description of corner evidence found and/or method applied in restoring or reestablishing corner:

- WAYNE COUNTY ROAD COMM. 1970 MON. IN BOX
+ RIM W/S MANHOLE E 40.07 (MEAS. 40.07)
DE POLE SW 62.17 (MEAS. 62.21)
TOP HYDRANT NW 71.88 (MEAS. 71.92)
LCRC L 20027 P 888 RC 575 1/2" IRON BAR IN CONC. IN MON. BOX
WCRRC BRASS TAG SE SIDE 14" ELM NE 107.05 (NOT MEAS.)
PUNCH WCRRC PBM #30-145 E 38.62 (GONE)
WCRRC TAG SW SIDE DE POLE SE 50.25 (MEAS. 50.24)
WCRRC TAG SW SIDE DE POLE SW 62.20 (MEAS. 62.21)
WCRRC TAG NE SIDE 16" OAK NW 100.17 (MEAS. 100.16)

ALSO LCRC L23419 P066 RC898

C. Description of monument for corner and accessories established to perpetuate locating the position of the corner:
FOUND 1/2" IRON ENCASED IN CONC., IN MON BOX SET REMONUMENTATION DISK WITH CAP RJL RLS 16933
SELECTED LOCATION IS ACCEPTED BY THE CONTRACTOR AND IS GENERALLY ACCEPTED BY PROFESSIONAL SURVEYORS AS THE BEST AVAILABLE EVIDENCE OF THE POSITION OF THE ORIGINAL CORNER.

- FOUND + RIM WEST SIDE MANHOLE S79°E 40.07
FOUND WCRRC TAG SW SIDE DE POLE S32°E 50.24
SET WCR TAG NE SIDE 5" TREE N50°W 46.70
FOUND CENTER TOP HYDRANT N26°W 71.92
FOUND WCRRC TAG NE SIDE 24" OAK N19°W 100.16
FOUND WCRRC TAG NW SIDE DE POLE S67°W 62.21

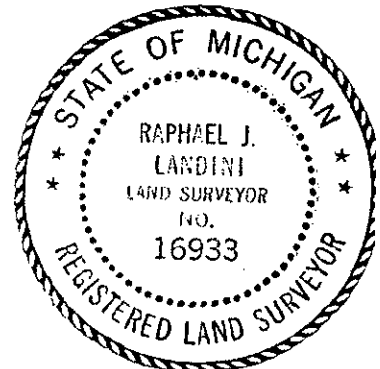

93 DEC 22 AM 10:20
FOREST E. YOUNGBLOOD
REGISTER OF DEEDS
MICHIGAN STATE DEPT. OF NAT. RES.

Signed by Raphael Landini Date DECEMBER 17, 1993

Surveyor's Michigan License No. 16933

Handwritten initials '2L' and '11K D'.