

LAND CORNER RECORDATION CERTIFICATE  
Filing Requirement of Act 74, Mich. P.A. 1970

FEB 28 1994

For corners in

Wayne COMMISSION  
(County)

Located In:

Corner Code #

1. Public Land Survey	T 3 S. R 8 E.	G-7
	T _____ R _____	_____
	T _____ R _____	_____
	T _____ R _____	_____
2. Property Controlling in Section	S _____ T _____ R _____	_____
	S _____ T _____ R _____	_____
3. Miscellaneous Property in Sec.	S _____ T _____ R _____	_____
	S _____ T _____ R _____	_____

Compliance with  
ACT 345, P.A. 1990

APPROVED ON: 12-7-93  
WAYNE COUNTY REMONUMENTATION  
PEER GROUP COMMITTEE

Register of Deeds Stamp & File Number

4. Lot No. \_\_\_\_\_, Recorded Plat \_\_\_\_\_  
5. Private Claims \_\_\_\_\_

A	B	C	D	E	F	G	H	I	J	K	L	M
2	6	5	4	3	2	1						
3												
4	7	8	9	10	11	12						
5												
6	18	17	16	15	14	13						
7												
8	19	20	21	22	23	24						
9												
10	30	29	28	27	26	25						
11												
12	31	32	33	34	35	36						
13												

I, William L. Roskelly, in a field survey on October 29, 1993, do hereby certify that under requirements of P.A. 74, Michigan P.A. of 1970, the corner points mentioned in lines 1 and 2 above were in conformance with regulations and rules therefore as required in the current manual of survey instructions of the United States Department of the Interior, Bureau of Land Management or by a decree of a Court of Law and/or that the corner points mentioned in lines 3, 4 and 5 above were in conformance with the rules of the Michigan Board of Land Surveyors or by a Decree of a Court of Law; established, re-established, monumented, re-monumented, recovered, found as expressed below:

NOTE: Not more than 4 corners, all in the same town and range, may be recorded on this certificate.

A. Description of original monument and accessories and/or subsequent restoration: No G.L.O. Witnesses remain.

J. Wampler G.L.O. (1819) set corner. Witnesses: Poplar 11S46 E30 Sugar 23N23 E16 L.C.R.C. L.23419, P.65 on 7/16/89 Alvin Butterfield found a R.R. spike in monument box and set the following witnesses:  
N. 25° E. 28.82' "+" Mark of STA 23+00 S. bound Conc. Rd.  
N. 74° W. 19.80' "X" Cut in conc. curb  
S. 10° W. 70.89' "+" Mark of STA 22+ 00 S. bound Conc. Rd.  
N.E. 146.10' Center of crest on plaque I-94 bridge  
N.W. 124.13' 'X' on end of curb I-94 bridge


B. Description of corner evidence found and/or method applied in restoring or reestablishing corner:

Set concrete monument with steel bar in monument box.  
Verified section corner thru recorded document RC 897 L. 23419, P. 065 used recorded witness to set conc. mon.  
1) Road Station 23-00 "+" mark S. bound conc. N. 25° E. dist. 28.82  
2) Found X cut in conc. curb N. 74° W. dist. 19.80  
3) Road station 22+00 "+" mark S. bound conc. S. 10° W. dist. 70.89

C. Description of monument for corner and accessories established to perpetuate locating the position of the corner:

G-7: Section corner 15, 16, 21 & 22 T.3S., R.8E., set conc. mon. with steel bar in monument box. The selected location is accepted by the Contractor and is generally accepted by professional surveyors as the best available evidence of the position of the original corner. Placed Wayne Co. brass disk with license #10705.  
1. Set PK & Tag 10705 in conc. curb S. 70° E. dist. 62.62  
2. Set WCR Tag Top of wood guard rail support S. 50° W. dist. 33.53  
3. Set WCR Tag Top of wood guard rail support N. 60° W. dist. 20.34  
4. Set WCR Tag Top of wood guard rail support N. 10° W. dist. 40.89  
5. Found PK nail N. 70° W. in asphalt shoulder dist. 13.95

RECORDED  
INDEXED  
OCT 29 1993  
11 21 11

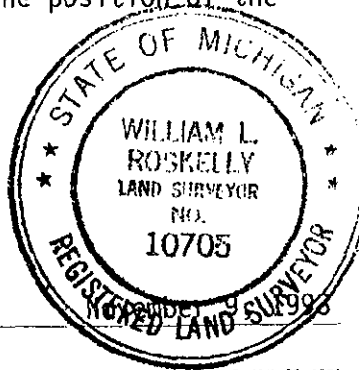

Signed by William L. Roskelly Date \_\_\_\_\_  
Surveyor's Michigan License No. 10705

2R 11KD