

LAND CORNER RECORDATION CERTIFICATE
Filing Requirement of Act 74, Mich. P.A. 1970

FEB 28 1994

For corners in

Wayne COMMISSION Located In: _____ Corner Code 6-10
(County)

1. Public Land Survey	T	<u>3</u>	SR	<u>8</u>	E.	<u>6-10</u>
	T	_____	R	_____	_____	_____
	T	_____	R	_____	_____	_____
	T	_____	R	_____	_____	_____
2. Property Controlling in Section	S	_____	T	_____	R	_____
	S	_____	T	_____	R	_____
3. Miscellaneous Property in Sec.	S	_____	T	_____	R	_____
	S	_____	T	_____	R	_____

Compliance with ACT 345, P.A. 1990
APPROVED ON: 12-7-93
WAYNE COUNTY REMONUMENTATION
PEER GROUP COMMITTEE

Register of Deeds Stamp & File Number

4. Lot No. _____, Recorded Plat _____
5. Private Claims _____

	A	B	C	D	E	F	G	H	I	J	K	L	M
2	6		5		4		3		2		1		
3													
4	7		8		9		10		11		12		
5													
6	18		17		16		15		14		13		
7													
8	19		20		21		22		23		24		
9													
10	30		29		28		27		26		25		
11													
12	31		32		33		34		35		36		
13													

I, William L. Roskelly in a field survey on October 29, 19 93, do hereby certify that under requirements of P.A. 74, Michigan P.A. of 1970, the corner points mentioned in lines 1 and 2 above were in conformance with regulations and rules therefore as required in the current manual of survey instructions of the United States Department of the Interior, Bureau of Land Management or by a decree of a Court of Law and/or that the corner points mentioned in lines 3, 4 and 5 above were in conformance with the rules of the Michigan Board of Land Surveyors or by a Decree of a Court of Law; established, re-established, monumented, re-monumented, recovered, found as expressed below:

NOTE: Not more than 4 corners, all in the same town and range, may be recorded on this certificate.

A. Description of original monument and accessories and/or subsequent restoration:


No G.L.O. Witnesses remain
L.C.R.C. L. 20182, P. 167 on 7/13/78 Water Z. Bikowski found concrete mon. in mon. box, and recorded the following witnesses;
P.K. Nail S. side power pole N. 85° W. - 58.91'
N.E. corner of brick pillar S. 45° W. - 82.15'
P.K. nail N. side Guy light pole S. 55° E. - 74.15'
P.K. Nail S. side of D.E. pole S. 85° E. - 48.04'

B. Description of corner evidence found and/or method applied in restoring or reestablishing corner:

Found monument box conc. mon. steel bar
Verified section corner thru recorded document RD 599 L. 20182, Pg. 167
S. 45° NE corner brick pillar R & M 82.15
found & checked thru witnesses

C. Description of monument for corner and accessories established to perpetuate locating the position of the corner:

G-10: Section corner 27 & 28 T.3 S.R.8 E. found mon. box with concrete mon. steel bar. The selected location is accepted by the Contractor and is generally accepted by professional surveyors as the best available evidence of the position of the original corner. Placed Wayne County disk with Top bolt hydrant n. 40° E. dist. 64.25 license #10705.
Set WCR Tag south face Guy pole due East dist. 48.02
Set WCR Tag north face light pole S. 52° E. dist. 74.10
N.E. corner of southerly brick pillar S. 45° W. dist. 82.15
Set WCR Tag south face P. pole due West 58.81

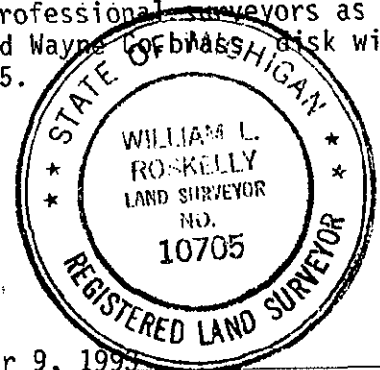

Signed by William L. Roskelly
Surveyor's Michigan License No. 10705

Date November 9, 1993

2R 11K