13.00 MISCELLANEOUS RECORDING 28 DEC 94 8:22 A.N.


RECORDED

RECEIPTA 128

COMMISSION

LAND CORNER RECORDATION CERTIFICATE DE TOUR REGISTER OF DEEDS HAVE COUNTY

		Filing Requir	Filing Requirement of Act 74, with F.A. 1970			ANDERES HI	
For	Wayne (County)	_ Located In:	Corner Code ##	LI27800PA065			
1.	Public Land Survey	T <u>3 S R 8 E</u> T R T R T R	G-13	WAYNI	Compliance with ACT 345, P.A. 1990 APPROVED ON: 12-8-94-01 WAYNE COUNTY REMONUMENTATION		
	Property Controlling in Section Miscellaneous Property in Sec.	S T R S T R S T R S T R			PEER GROUP (Number
5.	Private Claims	corded Plat		2 3 4	78	E F G H	1 J K L
do h in li curr Mar abo Cou exp NO	nereby certify that under requines 1 and 2 above were intent manual of survey instructing ment or by a decree of a vewere in conformance with urt of Law; established, repressed below: TE: Not more than 4 coon this certificate.	in a field survey on NOVEMbe irements of P.A. 74, Michigan P.A. conformance with regulations are ctions of the United States Department of Law and/or that the cornel the rules of the Michigan Board restablished, monumented, reservers, all in the same town a	of 1970, the corner points mend rules therefore as require riment of the Interior, Bureau er points mentioned in lines 3 of Land Surveyors or by a Demonumented, recovered, found range, may be recorded.	entioned 6 d in the of Land 7 , 4 and 5 8 cree of a 9 pund as 10 ed 11	-18 - 17	21 22 27 27 33 34 34	-23 -23 -26 -35
G-IGNA WAS NOT BE GAN AND CO	13) SOUTH CORNER .O. (1830's) J. Wole 12 W.45 (gone) P.A. (1930's) foun W. 54.36 U.S.G. mo E. 46.20 U.S.G. mo yne County Road Co " Ash (gone), S.W. E. pole (measured R.C.'s or C.S.'s Description of corner ev 13) SOUTH CORNER und a steel bar co mis Roads ±. Corne 12 to G-13 W.P.A. 13 to H-13 W.P.A. gle line G-12 & G- gle line G-12 & G- rner also supporte	mm. 4/22/70 E. Johns 34.05 top center hyd 29.73), E. 26 ± W. ed found on file at Ways idence found and/or method COMMON TO SECTIONS 33 ncrete monument in a r location supported = 2629.20 Measured = 2651.50 Measured 11 to G-12 & G-13 W. d by:	AND 34, T.3 S.,R itnesses:Elm 18 S. N.W. 37.62 Cross 88.24 36" Elm (gor found a monument d. (Measured 33.85 dge Sumpter Road. ne County Reg. of applied in restoring or re AND 34, T.3 S.,R mon. box at the in by comparing W.P. 2629.18 2651.96 P.A. = 90° 34' 20" P.A. = 181° 03' 05	.8 E. 31 E.6 (go on base of ne), E. 39. in mon.box.), S.E. (no Deeds. establishing co .8 E. ntersection A. survey w Measured " Measured	conc. sign of sumptricts of Sumptricts field = 90° 33° = 181° 0°	s: S.W. (notes) er and measurer 56" 2' 21"	9.85 nents.
W. W.	C.R.C. Witness: Fo C.B.O.T. Witness #	und top bolt of hydra 163 found mon. box c	ant kecord = 34.U5 onc. mon. steel ba	r due East	Rec. 39.9	33.0: 1 Meas. :	= 40.15
							~

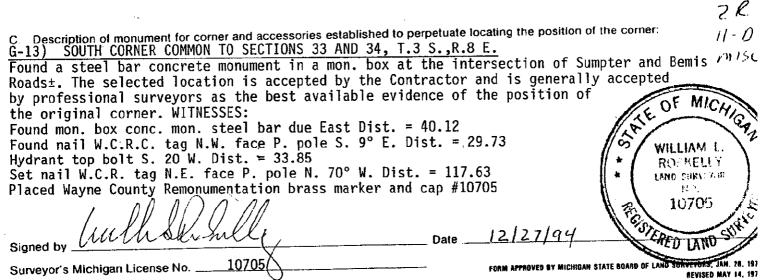

REVISED MAY 14, 197 REVISED JAN., 198