

SURVEY & REMONUMENTATION

APR 25 1995

RC 1573

L127800PA066

\$ 16.00 MISCELLANEOUS RECORDING
 28 DEC 94 8:22 A.M. RECEIVED FOR
 DELIVERED
 FOREST E. VOLPELODD, REGISTER OF DEEDS
 WAYNE COUNTY, MI

COMMISSION

LAND CORNER RECORDATION CERTIFICATE
Filing Requirement of Act 74, Mich. P.A. 1970

For corners in

<u>Wayne</u> (County)	Located In:	Corner Code-#
1. Public Land Survey	T <u>3</u> S. R. <u>8</u> E.	<u>I-2</u>
	T _____ R _____	_____
	T _____ R _____	_____
	T _____ R _____	_____
2. Property Controlling In Section	S _____ T _____ R _____	<u>Pg. 1 of 2</u>
	S _____ T _____ R _____	_____
3. Miscellaneous Property in Sec.	S _____ T _____ R _____	_____
	S _____ T _____ R _____	_____
4. Lot No. _____, Recorded Plat _____		
5. Private Claims _____		

Compliance with
 ACT 345, P.A. 1990
 APPROVED ON: 12-8-94 *WJ*
 WAYNE COUNTY REMONUMENTATION
 PEER GROUP COMMITTEE

Register of Deeds Stamp & File Number

RC 1573

A	B	C	D	E	F	G	H	I	J	K	L	M
2	6	5	4	3	2	1						
3												
4	7	8	9	10	11	12						
5												
6	18	17	16	15	14	13						
7												
8	19	20	21	22	23	24						
9												
10	30	29	28	27	26	25						
11												
12	31	32	33	34	35	36						
13												

I, William L Roskelly in a field survey on October 1, 19 94, do hereby certify that under requirements of P.A. 74, Michigan P.A. of 1970, the corner points mentioned in lines 1 and 2 above were in conformance with regulations and rules therefore as required in the current manual of survey instructions of the United States Department of the Interior, Bureau of Land Management or by a decree of a Court of Law and/or that the corner points mentioned in lines 3, 4 and 5 above were in conformance with the rules of the Michigan Board of Land Surveyors or by a Decree of a Court of Law; established, re-established, monumented, re-monumented, recovered, found as expressed below:

NOTE: Not more than 4 corners, all in the same town and range, may be recorded on this certificate.

A. Description of original monument and accessories and/or subsequent restoration:

I-2) Section Corner West Section 2, T.3 S.,R.8 E.

G.L.O. (1830's) J. Wampler set corner, Witnesses W. 0 11 S68 W8 (gone), Lynn 5N 11 E7 (gone)
 W.P.A. (1930's) found iron and stone, Witnesses N.W. 24.64 fence post (gone), S.E. 49.12 30" Maple (found M.49.12) N.E. 31.50 18" Maple (found M. 31.10), N.E. 32.57 iron fence post (gone), N.E. 77.80 30" Elm (gone)
 Wayne County Road Commission 6/5/70 E. Johns found an iron, witnesses:
 N.E. 43.41 D.E. pole (found measured 43.31) W. 33.00 iron pipe (found measured 33.16)
 S.E. 49.12 26" Maple (found measured 49.21) N.E. 31.17 24" Maple (found measured 31.10)
 No R.C.'s or C.S.'s on file at Wayne County Reg. of Deeds.

B. Description of corner evidence found and/or method applied in restoring or reestablishing corner:

I-2) Section Corner West Section 2, T.3 S.,R.8 E.

Found a 1" iron centerline of Morton Taylor Road. Compared field measurements with W.P.A. survey.

I-2 to I-3 W.P.A. = 2685.44 Measured = 2685.98
 I-3 to H-3 W.P.A. = 2690.42 Measured = 2690.97
 I-3 to J-3 W.P.A. = 2812.67 Measured = 2812.85

Line I-3 to I-2 - I3 to H3 W.P.A. = 90° 54' 20" Measured = 90° 51' 11"
 Line I-3 to I-2 - I3 to J3 W.P.A. = 89° 23' 00" Measured = 89° 23' 35"

Additional verification: W.P.A. (1930's) Witness 18" Maple N.E. 31.50 Measured 31.10, S.E. 49.12 30" Maple Measured 49.21


(continued to page 2)

C. Description of monument for corner and accessories established to perpetuate locating the position of the corner:

I-2) Section Corner West Section 2, T.3 S.,R.8 E.

Found a 1" iron centerline of Morton Taylor Road. (Dirt Road)
 The selected location is accepted by the Contractor and is generally accepted by professional surveyors as the best available evidence of the position of the original corner.
 Found P.K. nail & tag W.C.R.C. N.W. face P. pole N.39° E dist: 43.31
 Found nail & tag GLA 28400 South face 24" Maple N.80° E dist: 31.10
 Found nail & tag GLA 28400 N.E. face 30" Maple S.32° E dist: 49.21
 Found nail & tag GLA 28400 East face P. pole S.24° W dist: 58.98
 Found iron pipe due West dist: 33.16
 Placed Wayne County Remonumentation brass marker stamped with 10705.

ZR
14-D
MISC

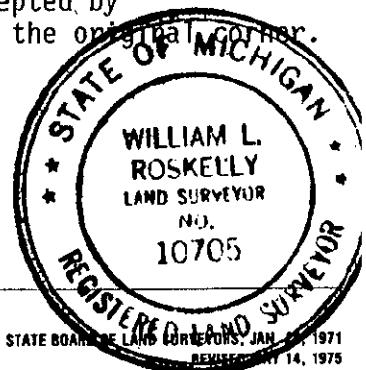

Signed by William L Roskelly Date 12/27/94

Surveyor's Michigan License No. 10705

LAND CORNER RECORDATION CERTIFICATE
Filing Requirement of Act 74, Mich. P.A. 1970

LI27800PA067

For corners in

Wayne
(County)

Located In:

Corner Code #

- | | | |
|---------------------------------------|---------------------------|------------------|
| 1. Public Land Survey | T <u>3</u> S R <u>8</u> E | <u>I-2</u> |
| | T ___ R ___ | _____ |
| | T ___ R ___ | _____ |
| | T ___ R ___ | <u>Pg 2 of 2</u> |
| 2. Property Controlling
in Section | S ___ T ___ R ___ | _____ |
| | S ___ T ___ R ___ | _____ |
| 3. Miscellaneous
Property in Sec. | S ___ T ___ R ___ | _____ |
| | S ___ T ___ R ___ | _____ |

Compliance with
 ACT 345, P.A. 1990

APPROVED ON: 12-8-94
 WAYNE COUNTY REMONUMENTATION
 PEER GROUP COMMITTEE

Register of Deeds Stamp & File Number

4. Lot No. _____, Recorded Plat _____
 5. Private Claims _____

I, _____, in a field survey on _____, 19____, do hereby certify that under requirements of P.A. 74, Michigan P.A. of 1970, the corner points mentioned in lines 1 and 2 above were in conformance with regulations and rules therefore as required in the current manual of survey instructions of the United States Department of the Interior, Bureau of Land Management or by a decree of a Court of Law and/or that the corner points mentioned in lines 3, 4 and 5 above were in conformance with the rules of the Michigan Board of Land Surveyors or by a Decree of a Court of Law; established, re-established, monumented, re-monumented, recovered, found as expressed below:

NOTE: Not more than 4 corners, all in the same town and range, may be recorded on this certificate.

	A	B	C	D	E	F	G	H	I	J	K	L	M
2	6		5		4		3	●	2		1		
3													
4	7		8		9		10		11		12		
5													
6	18		17		16		15		14		13		
7													
8	19		20		21		22		23		24		
9													
10	30		29		28		27		26		25		
11													
12	31		32		33		34		35		36		
13													

A. Description of original monument and accessories and/or subsequent restoration:


B. Description of corner evidence found and/or method applied in restoring or reestablishing corner:

(continued from page 1)

Wayne County Road Commission 6/5/70 E. Johns found an iron, witnesses:

- N.E. 43.41 D.E. pole (found measured 43.31)
- W. 33.00 iron pipe (found measured 33.16)
- S.E. 49.12 26" Maple (found measured 49.21)
- N.E. 31.17 24" Maple (found measured 31.10)

C. Description of monument for corner and accessories established to perpetuate locating the position of the corner:

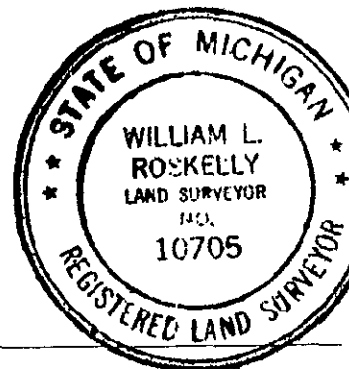

Signed by William L. Roskelly Date 12/27/94
 Surveyor's Michigan License No. 10705