

FEB 28 2000

FILE DO NOT MAIL

LAND CORNER RECORDATION CERTIFICATE
Filing Requirement of Act 74, Mich. P.A. 1970

SECTION

For corners in
Wayne, Van Buren Twp.
(County)

Located In: Corner Code #

Liber-30845 Page-16
99592645 12/28/1999
F.E. Youngblood, Wayne Co. Register of Deeds
RDANDSYL

1. Public Land Survey	T	3S.	R	8E.	I-8
	T		R		
	T		R		
	T		R		
2. Property Controlling in Section	S	T	R		
	S	T	R		
3. Miscellaneous Property in Sec.	S	T	R		
	S	T	R		

Compliance with
ACT 345, P.A. 1990

APPROVED ON: DEC 9, 1999

WAYNE COUNTY REMONUMENTATION
PEER GROUP COMMITTEE

Register of Deeds Stamp & File Number

4. Lot No. _____, Recorded Plat _____
5. Private Claims _____

I, William L. Roskelly, in a field survey on Nov 9, 1999 do hereby state that under requirements of P.A. 74, Michigan P.A. of 1970, the corner points mentioned in lines 1 and 2 above were in conformance with regulations and rules therefore as required in the current manual of survey instructions of the United States Department of the Interior, Bureau of Land Management or by a decree of a Court of Law and/or that the corner points mentioned in lines 3, 4 and 5 above were in conformance with the rules of the Michigan Board of Land Surveyors or by a Decree of a Court of Law; established, re-established, monumented, recovered, found as expressed below:

NOTE: Not more than 2 corners, all in the same town and range, may be recorded on this certificate.

A	B	C	D	E	F	G	H	I	J	K	L	M
1												
2	6		5		4		3		2		1	
3												
4	7		8		9		10		11		12	
5												
6	18		17		16		15		14		13	
7												
8	19		20		21		22		23		24	
9												
10	30		29		28		27		26		25	
11												
12	31		32		33		34		35		36	
13												

A. Description of original monument and accessories and/or subsequent restoration:

I-8) East corner section 22, T.3 S., R.8 E., Van Buren Township
G.L.O. (1830's) J Wampler set corner post, witnesses: Iron'd 9 S8 W16, Dog'd 8 N80 E15
W.P.A. (1930's) iron set, witnesses: N 78.20' 36" Sycamore (meas. N06°01'51"E 78.31'), NE 25.02' SW corner porch #43390 (meas. N22°18'27"E 24.99'), NE 11.68' SW corner house #43390 (meas. N48°58'20"E 11.45'), NE 33.02' SE corner house #43390 (gone), SE 54.03' 14" Elm(gone).

B. Description of corner evidence found and/or method applied in restoring or reestablishing corner:


I-8) East corner section 22, T.3 S., R.8 E., Van Buren Township
Found a concrete monument with an iron pipe natural ground.
Verified corner location by comparing W.P.A. data with field measurements:
I-8 to I-7 Record = 2663.22' Measured = 2663.14' I-8 to I-9 Record = 2663.14' Measured = 2663.81'
Angle line I-8 & I-7 to I-8 & I-9 Record = 179°18'-30" Measured 179°19'-45"
WPA 1930's : N 78.20' 36" Sycamore (meas. N06°01'51"E 78.31'), NE 25.02' SW corner porch #43390 (meas. N22°18'27"E 24.99'), NE 11.68' SW corner house #43390 (meas. N48°58'20"E 11.45').

C. Description of monument for corner and accessories established to perpetuate locating the position of the corner:

I-8) East corner section 22, T.3 S., R.8 E., Van Buren Township
Found a concrete monument with an iron pipe natural ground.
The selected location is accepted by the contractor and is generally accepted by professional surveyors as the best available evidence of the position of the corner. WITNESSES: Set nail WCR tag W face 36" Sycamore N6°01'51"E. 78.31', found SW corner chimney N22°18'27"E 24.99', found SW corner cottage. N48°58'20"E 11.45', found SE corner cottage. N87°16'57"E 46.72', set nail and WCR tag W face 30" Maple S21°40'39"E 33.67', set steel bar cap #10705 S86°43'01"W 15.22', set nail and WCR tag E face 15" Elm N60°54'34"W 60.09', set steel bar cap # 10705 N00°36'44"W 43.33', set nail and WCR tag SW face 6" twin Elm N32°01'32"W 5.59'.
Set nail and Wayne County Remonumentation tag and B&S #10705 in iron pipe.

Signed by William L. Roskelly
Surveyor's Michigan License No. 10705

Date 12/28/99

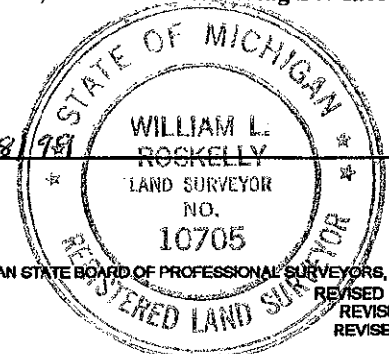

R LCR 9 4R 1 Pa A DB