

MAR 02 1999

DEC 29 1998

SECTION

FILE DO NOT MAIL

LAND CORNER RECORDATION CERTIFICATE
Filing Requirement of Act 74, Mich. P.A. 1970

\$10.00 DEED
\$4.00 REMONUMENTATION

For corners in

Wayne, Van Buren Twp.
(County)

Located in:

Corner Code #

1. Public Land Survey

T	3S.	R	8E.	J-5
T		R		
T		R		
T		R		

2. Property Controlling in Section


S		T	R	
S		T	R	
S		T	R	
S		T	R	

3. Miscellaneous Property in Sec.

4. Lot No. _____, Recorded Plat _____
5. Private Claims _____

I, William L. Roskelly, in a field survey on Dec 28, 1998 do hereby state that under requirements of P.A. 74, Michigan P.A. of 1970, the corner points mentioned in lines 1 and 2 above were in conformance with regulations and rules therefore as required in the current manual of survey instructions of the United States Department of the Interior, Bureau of Land Management or by a decree of a Court of Law and for that the corner points mentioned in lines 3, 4 and 5 above were in conformance with the rules of the Michigan Board of Land Surveyors or by a Decree of a Court of Law; established, re-established, monumented, recovered, found as expressed below:

NOTE: Not more than 2 corners, all in the same town and range, may be recorded on this certificate.

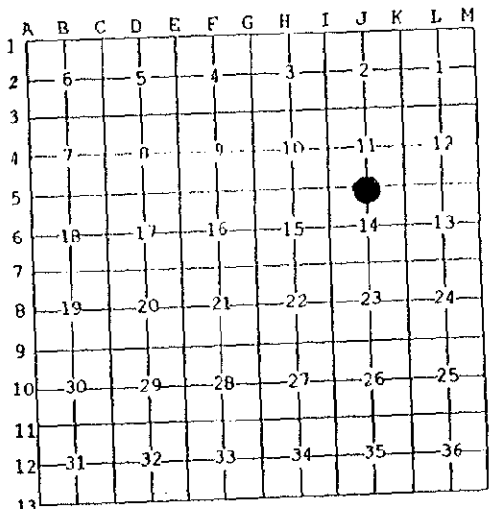

A. Description of original monument and accessories and/or subsequent restoration:

J-5 South corner section 11, T.3 S., R.8 E., Van Buren Township

G.L.O. (1830's) Joseph Fletcher set corner post, witnesses: B. Walnut 24 S8 E21 (gone), Hicky 5N16 E7 (gone) 4/24/70 E. Johns WCRC found mon., witnesses: NW 55.85' 60" Oak (gone), NW 24.45' cen. WGW cover (M=24.03'), NE 32.67' MSHD tag Ed. pole (gone), SW 62.40' twin 12" Cherry (gone). 1/27/87 R. Landini WCRC found mon., witnesses: NE 136.03' SW cor. DE tower W of 2 angle iron base (M=135.95'), due N. 60.01' cl 4" fence post westerly of 2 (M=60.06'+/-), NW 77.87' PK nail w/brass tag 27" tree (gone), SW 62.87' PK nail w/tag twin 12" cherry (gone), due S 60.00' fence post (M=60.01'), SE 52.95' PK nail tag DE pole (M=52.84') 5/20/88 RC#938 L. 24088, P. 283 Gregory Stephens found a conc. mon, witnesses: N. 37°W. 123.72' SE corner brick townhouse #9335 (M=123.85'), N.74°W. 77.83' to PK w/WCRC tag in S. face 20" Maple (gone), S.20°W. 62.73' to PK w/WCRC tag in NW face twin 20" Cherry (gone).

J-5 South corner section 11, T.3 S., R.8 E., Van Buren Township

Found a concrete monument with steel bar in a monument box centerline of Tyler Road (asphalt). Verified corner location by comparing W.P.A. data with field measurements. J-5 to K-5 Record = 2812.99 Measured = 2813.67' J-5 to I-5 Record = 2888.14' Measured = 2889.45' Angle line J-5 & K-5 to J-5 & I-5 Record = 181°-06'-30" Measured = 181°-07'-28"

C. Description of monument for corner and accessories established to perpetuate locating the position of the corner:


J-5 South corner section 11, T.3 S., R.8 E., Van Buren Township

Found a concrete monument with steel bar in a monument box centerline of Tyler Road (asphalt). The selected location is accepted by the contractor and is generally accepted by professional surveyors as the best available evidence of the position of the corner. WITNESSES: Found PK nail, tag #19837 SW face MBT pole N.7°-18'-06"E. 32.19', found PK nail and tag GW68617 E. face MBT pole N.8°-10'-49"E. 32.67', found SW cor. DE tower #0622 westerly of 2 angle iron base N.42°-10'-14"E. 135.95', set steel bar w/cap # 10705 S.53°-40'-23"E. 59.93', found PK nail w/tag # GW68618 E. face P. pole S.12°-04'-29"E. 52.84', found PK nail WCRC tag W. face P.pole S.9°-58'-43"E. 52.84', found PK nail and tag #19837 N. face P. pole S.10°-55'-11"E. 51.80', found top of E. chain link fence post easterly line of two S.0°-33'-18"E. 60.01', found PK nail and tag GW 68619 E. face 24" twin cherry S.18°-42'-16"W. 63.53', found PK nail and tag #17618 NW face 24" twin cherry (over)

Signed by William L. Roskelly
Surveyor's Michigan License No. 10705

Date DEC 28, 1998

R LCR 10 4R ZPG U. J.P.L.

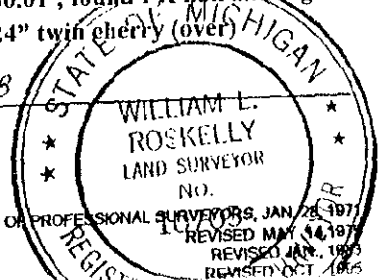

LIBRARY ROOMS

0848687515
12/29/1998 11:55AM