

LAND CORNER RECORDATION CERTIFICATE

Filing Requirement of Act 74, Mich. P.A. 1970

For corners in FEB 28 1994

Wayne COMMISSION Located In: Corner Code K-2

1. Public Land Survey T 3 S R 8 E. K-2  
 T \_\_\_\_\_ R \_\_\_\_\_  
 T \_\_\_\_\_ R \_\_\_\_\_  
 T \_\_\_\_\_ R \_\_\_\_\_

2. Property Controlling S \_\_\_\_\_ T \_\_\_\_\_ R \_\_\_\_\_  
 in Section S \_\_\_\_\_ T \_\_\_\_\_ R \_\_\_\_\_

3. Miscellaneous S \_\_\_\_\_ T \_\_\_\_\_ R \_\_\_\_\_  
 Property in Sec. S \_\_\_\_\_ T \_\_\_\_\_ R \_\_\_\_\_

Compliance with ACT 345, P.A. 1990  
 APPROVED ON: 12-7-93 *[Signature]*  
 WAYNE COUNTY REMONUMENTATION  
 PEER GROUP COMMITTEE

Register of Deeds Stamp & File Number

4. Lot No. \_\_\_\_\_, Recorded Plat \_\_\_\_\_  
 5. Private Claims \_\_\_\_\_

A	B	C	D	E	F	G	H	I	J	K	L	M
2	6	5	4	3	2	1						
3												
4	7	8	9	10	11	12						
5												
6	18	17	16	15	14	13						
7												
8	19	20	21	22	23	24						
9												
10	30	29	28	27	26	25						
11												
12	31	32	33	34	35	36						
13												


I, William L. Roskelly in a field survey on November 2, 19 93, do hereby certify that under requirements of P.A. 74, Michigan P.A. of 1970, the corner points mentioned in lines 1 and 2 above were in conformance with regulations and rules therefore as required in the current manual of survey instructions of the United States Department of the Interior, Bureau of Land Management or by a decree of a Court of Law and/or that the corner points mentioned in lines 3, 4 and 5 above were in conformance with the rules of the Michigan Board of Land Surveyors or by a Decree of a Court of Law; established, re-established, monumented, re-monumented, recovered, found as expressed below:

**NOTE: Not more than 4 corners, all in the same town and range, may be recorded on this certificate.**

A. Description of original monument and accessories and/or subsequent restoration:  
 No G.L.O. Witnesses remain. C.S. 184 L. 18102, P. 545 & 546 on 7/22/72 Raphael Landini recorded the following witnesses: N.85°E. 54.88' to utility pole. S.30°E. 97.29' to silver Maple. N.25°W. 100.34' to 8" Poplar. N.35°W. 74.81' to top of hyd. L.C.R.C. L. 19990 P. 613 on 12/12/77. R. W. Swanson found a concrete mon. in mon. box and recorded the following witnesses: N.W. 100.24' to nail with brass tag in S.W. side of 12" Ash. N.N.E. 54.83' to nail with brass tag in S. side of Detroit Edison Pole. S.E. 124.83' to nail with brass tag in N.E. side of 8" Elm. S.S.E. 61.17' to "x" cut in pavement at Road Station 624+00. W. 5.00' to "x" cut in pavement one foot west of east edge of pavement.

B. Description of corner evidence found and/or method applied in restoring or reestablishing corner:  
 Found monument box with steel bar  
 Verified section corner thru document Rc 568 L. 19990 Pg. 613/614  
 N.W. tag in 12" Ash could not find tag. Meas. 99.90 to tree recorded 100.24  
 S.E. found tree no tag. meas. 125± to tree recorded 124.83  
 S.S.E. recorded as 61.17 see #3 below meas. 61.19  
 West 5.00 to cross in pavement meas. 5.00 see #4 below

C. Description of monument for corner and accessories established to perpetuate locating the position of the corner:  
 K-2: Section corner 1 & 2 T.3 S.R.8 E. Found mon. box with steel bar. The selected location is accepted by the Contractor and is generally accepted by professional surveyors as the best available evidence of the position of the original corner. Placed Wayne Co. brass disk with license #10705.  
 "x" cut in pavement road station 625+00 N. 40° E. dist. 45.72  
 "x" cut in sanitary M.H. north rim S. 40° E. dist. 60.75  
 "+" cut in pavement road station 624+00 S. 10° E. dist. 61.19  
 Found "x" cut in pavement due West dist. 5.00  
 Top bolt of hydrant N. 24° W. dist. 74.58  
 Set WCR Tag S.W. face 18" Elm N. 20° W. dist. 99.90

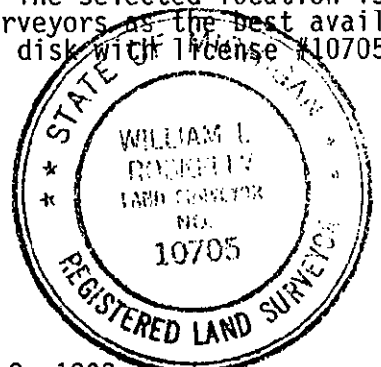

Signed by William L. Roskelly Date November 9, 1993  
 Surveyor's Michigan License No. 10705

*2C 11KD*