

FEB 28 1994

LAND CORNER RECORDATION CERTIFICATE
Filing Requirement of Act 74, Mich. P.A. 1970

For corners in COMMISSION
Wayne (County)

Table with 3 columns: Item, Located In, Corner Code. Row 1: Public Land Survey, T 3 S R 8 E, K-3. Row 2: Property Controlling in Section, S T R. Row 3: Miscellaneous Property in Sec., S T R.

Compliance with ACT 345, P.A. 1990
APPROVED ON: 12-7-93 [Signature]
WAYNE COUNTY REMONUMENTATION PEER GROUP COMMITTEE
Register of Deeds Stamp & File Number

4. Lot No. Recorded Plat
5. Private Claims

Grid table with columns A-M and rows 1-13. A dot is marked at row 3, column K.

William L. Roskelly in a field survey on November 2, 1993 do hereby certify that under requirements of P.A. 74, Michigan P.A. of 1970, the corner points mentioned in lines 1 and 2 above were in conformance with regulations and rules therefore as required in the current manual of survey instructions of the United States Department of the Interior, Bureau of Land Management or by a decree of a Court of Law and/or that the corner points mentioned in lines 3, 4 and 5 above were in conformance with the rules of the Michigan Board of Land Surveyors or by a Decree of a Court of Law; established, re-established, monumented, re-monumented, recovered, found as expressed below:


NOTE: Not more than 4 corners, all in the same town and range, may be recorded on this certificate.

A. Description of original monument and accessories and/or subsequent restoration:

No G.L.O. Witnesses remain
LCRC L. 19990, P. 615 on 12/12/77 R. Swanson found a conc. mon. in mon. box and recorded the following witnesses:
N.W. 82.28 ft. to nail with brass tag in S.W. side of Mich. Bell Co. pole.
N.E. 69.63 ft. " " " " " " S.E. " " Detroit Edison pole.
S.E. 82.06 ft. " "X" cut in N.W. bolt of handrail at N.E. wing wall of culvert S. of Ecorse Road.
S.W. 71.11 ft. " nail with brass tag in S.E. side of Detroit Edison pole.

B. Description of corner evidence found and/or method applied in restoring or reestablishing corner:

Found monument box with conc. mon. iron pipe at Haggerty & Ecorse Roads.
Also verified section corner thru document RC 569 L. 19990, Pg. 615,616
N.W. Tag in pole 82.28 could not find tag. Pole checks ± See #5 below
N.E. Tag in pole 69.69 " " " " " " ± See #1 below
S.E. X cut hand rail 82.06 meas. 82.10 See #2 below
S.W. Tag in pole at ground level 71.11 measured 71.80± dirt hump.

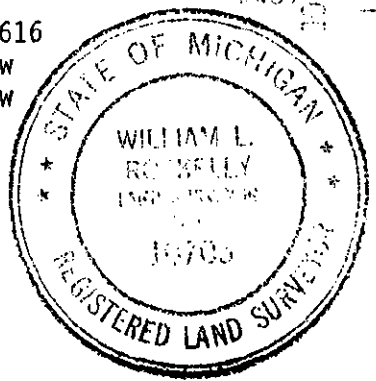

C. Description of monument for corner and accessories established to perpetuate locating the position of the corner:

K-3: Section corner 1,2,11 & 12 Found mon. box with conc. mon. iron pipe. The selected location is accepted by the Contractor and is generally accepted by professional surveyors as the best available evidence of the position of the original corner. Placed Wayne Co. brass disk with license #10705.
Set WCR Tag S.E. face P. pole N. 60° E. dist. 68.35
Found "X" cut in N.W. bolt of hand rail at N.E. wing wall S. 20° E. dist. 82.10
Set WCR Tag S.E. face P. pole S. 60° W. dist. 71.56
Set PK & Tag 10705 Top curb N. 30° W. dist. 59.75
Set WCR Tag S.W. face P. pole N. 36° W. dist. 81.21

Signed by [Signature] Date November 9, 1993
Surveyor's Michigan License No. 10705