

FILE DO NOT MAIL

LAND CORNER RECORDATION CERTIFICATE
 Filing Requirement of Act 74, Mich. P.A. 1970


For corners in

<u>Wayne, Van Buren Twp.</u> (County)	Located in:	Corner Code #
1. Public Land Survey	T <u>3S.</u> R <u>8E.</u>	<u>K-4</u>
	T ___ R ___	_____
	T ___ R ___	_____
	T ___ R ___	_____
2. Property Controlling in Section	S ___ T ___ R ___	_____
	S ___ T ___ R ___	_____
3. Miscellaneous Property in Sec.	S ___ T ___ R ___	_____
	S ___ T ___ R ___	_____

Compliance with
ACT 345, P.A. 1990
 APPROVED ON: 12-9-97 *DP*
**WAYNE COUNTY REMONUMENTATION
 PEER GROUP COMMITTEE**
 Register of Deeds Stamp & File Number

4. Lot No. _____, Recorded Plat _____
 5. Private Claims _____

I, William L. Roskelly, in a field survey on Nov 18, 1997 do hereby state that under requirements of P.A. 74, Michigan P.A. of 1970, the corner points mentioned in lines 1 and 2 above were in conformance with regulations and rules therefore as required in the current manual of survey instructions of the United States Department of the Interior, Bureau of Land Management or by a decree of a Court of Law and/or that the corner points mentioned in lines 3, 4 and 5 above were in conformance with the rules of the Michigan Board of Land Surveyors or by a Decree of a Court of Law, established, re-established, monumented, recovered, found as expressed below:

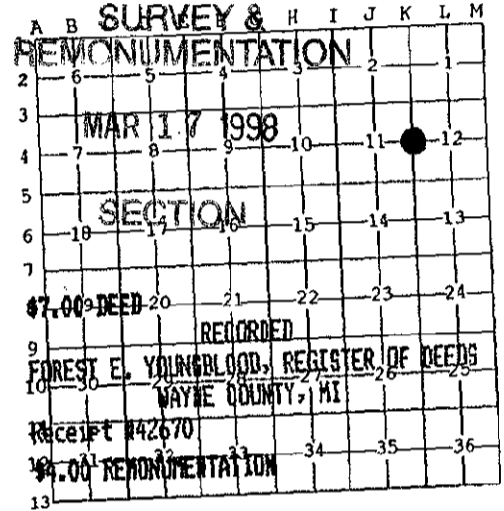

NOTE: Not more than 2 corners, all in the same town and range, may be recorded on this certificate.

A. Description of original monument and accessories and/or subsequent restoration:

K-4 East corner section 11, T.3 S., R.8 E., Van Buren Township
 G.L.O. (1816) J. Wampler set corner post, witnesses: BO16 S68 W21 (gone), Maple 14N38 E16 (gone), W.P.A. (1930's) found an iron, witnesses: N.E. 96.57' nail in 12" Cherry (gone), S.E. 86.78' nail in 5" Cherry (gone), S.W. 42.64' nail 6" Ash (gone), S.W. 35.78' nail in 6" twin Apple (gone) 10/30/72 R.C. 172 Edward P. O'Rourke found a monument in a monument box, witnesses: N 80° W 59.98' 1" iron pipe (not found), S 80° W 50.81' conc. nail w/flasher in headwall (gone).

B. Description of corner evidence found and/or method applied in restoring or reestablishing corner:

K-4 East corner section 11, T.3 S., R.8 E., Van Buren Township
 Found an iron pipe in concrete in a monument box at Haggerty road (asphalt).
 Verified the corner location by comparing field measurements with W.P.A. survey:
 Distance K-4 to K-3 Record = 2661.58', Measured = 2661.56'
 Distance K-4 to K-5 Record = 2681.57', Measured = 2681.57'
 Angle line K-4& K-3 to K-4 & K-5 Record = 179° 00' 40", Measured = 178° 59' 35"



C. Description of monument for corner and accessories established to perpetuate locating the position of the corner:

K-4 East corner section 11, T.3 S., R.8 E., Van Buren Township
 Found an iron pipe in concrete in a monument box at Haggerty road (asphalt).
 The selected location is accepted by the contractor and is generally accepted by professional surveyors as the best available evidence of the position of the corner.
 WITNESSES: Due East 60.10' found iron pipe, S. 45° E. 69.46' set steel bar S. side drive CL concrete walk, S. 30° E. 52.19' found mag nail & tag #21563 in approach curb, S. 50° W. 40.17' set steel bar with cap #10705 .20 W of W.Haggerty BOC, N. 55° W. 55.69' found PK nail WCRC tag S. face power pole, N. 55° W. 55.69' found a P.K. nail S. face power pole, N. 55° W. 55.88' found a P.K. nail S. face power pole.
 Placed PK nail and Wayne County Remonumentation tag and B&S tag #10705.

Signed by William L. Roskelly
 Surveyor's Michigan License No. 10705

Date 12-16-97