

SURVEY & REMONUMENTATION

RC 1261

LI 27015 PA 737

FEB 28 1994

COMMISSION

LAND CORNER RECORDATION CERTIFICATE  
Filing Requirement of Act 74, Mich. P.A. 1970

For corners in  
Wayne (County)

Located In:

Corner Code ##

- 1. Public Land Survey T 3 S R 8 E. K-11  
T \_\_\_ R \_\_\_  
T \_\_\_ R \_\_\_  
T \_\_\_ R \_\_\_
- 2. Property Controlling S \_\_\_ T \_\_\_ R \_\_\_  
in Section S \_\_\_ T \_\_\_ R \_\_\_
- 3. Miscellaneous S \_\_\_ T \_\_\_ R \_\_\_  
Property in Sec. S \_\_\_ T \_\_\_ R \_\_\_

Compliance with  
ACT 345, P.A. 1990

APPROVED ON: 12-7-93  
WAYNE COUNTY REMONUMENTATION  
PEER GROUP COMMITTEE

Register of Deeds Stamp & File Number

- 4. Lot No. \_\_\_\_\_, Recorded Plat \_\_\_\_\_
- 5. Private Claims \_\_\_\_\_

	A	B	C	D	E	F	G	H	I	J	K	L	M
2	6	5	4	3	2	1							
3													
4	7	8	9	10	11	12							
5													
6	16	17	16	15	14	13							
7													
8	19	20	21	22	23	24							
9													
10	30	29	28	27	26	25							
11													
12	31	32	33	34	35	36							
13													

William L. Roskelly, in a field survey on November 10, 19 93, do hereby certify that under requirements of P.A. 74, Michigan P.A. of 1970, the corner points mentioned in lines 1 and 2 above were in conformance with regulations and rules therefore as required in the current manual of survey instructions of the United States Department of the Interior, Bureau of Land Management or by a decree of a Court of Law and/or that the corner points mentioned in lines 3, 4 and 5 above were in conformance with the rules of the Michigan Board of Land Surveyors or by a Decree of a Court of Law; established, re-established, monumented, re-monumented, recovered, found as expressed below:

NOTE: Not more than 4 corners, all in the same town and range, may be recorded on this certificate.

A. Description of original monument and accessories and/or subsequent restoration:


No G.L.O. Witnesses remain. J. Wampler G.L.O. (1819) set cor. Witness: Hickory 9 S3 W18 W0 18 N88 E31  
LCRC L. 24405, P. 902 on 9/15/89 Martin Dunn set 1/2" 1. Rod with cap #30081, set by establishing East Section line from Supervisor's Van Buren Plat No. 7 (L.73 of plats P. 45, W.C.R.) and South section line from Moore Bros. Subn No. 2 (L. 73 of plats, P.97, W.C.R.)  
Set P.K. nail in west face of 10" Maple North - 29.31'  
Set P.K. Nail in south face 16' maple east - 10.41'  
Set P.K. Nail in east face 34" cottonwood south - 8.00'  
Set p.K. nail in south face 8" maple north west - 10.02

B. Description of corner evidence found and/or method applied in restoring or reestablishing corner:

Found Cap Iron Pipe #18603 #19836  
Verified thru survey job #VBN 0001-01 Daniel Sandomierski #24616  
Found PK nail S. side 15" tree N. 84° E. 29.58 R&M  
Found PK nail S.W. side 12" tree S. 54° E. 37.37 R&M  
Found PK nail E. side 18" tree S. 16° E. 37.52 R&M

C. Description of monument for corner and accessories established to perpetuate locating the position of the corner:

K-11: Section corner 25,26,35 & 36 found capped iron pipe #18603 & #19836. The selected location is accepted by the Contractor and is generally accepted by professional surveyors as the best available evidence of the position of the original corner. Placed Wayne Co. brass disk with licer #10705.  
Set WCR Tag East face 14" Maple N. 40° E. dist. 15.90  
Set WCR Tag South face 32" Oak due East dist. 29.83  
Set WCR Tag East face 30" Maple S. 10° E. dist. 37.50  
Set WCR Tag North face 18" Ash due West 21.71  
Measured South 2680± thru woods to E. 1/4 cor. Sec. 35 recorded as 2678.15 Govt. survey notes.

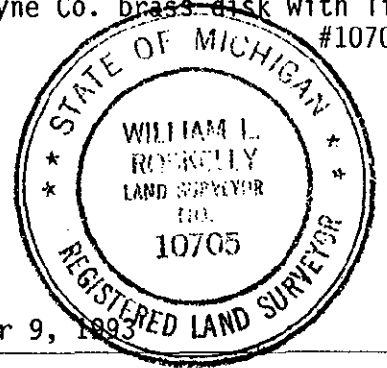

Signed by

*William L. Roskelly*

Date

November 9, 1993

Surveyor's Michigan License No. 10705

22 11K1