

FEB 28 1994

LAND CORNER RECORDATION CERTIFICATE
Filing Requirement of Act 74, Mich. P.A. 1970

For corners in COMMISSION

Table with columns: Wayne (County), Located In, Corner Code #. Includes entries for Public Land Survey, Property Controlling in Section, and Miscellaneous Property in Sec.

Compliance with ACT 345, P.A. 1990
APPROVED ON: 12-7-93
WAYNE COUNTY REMONUMENTATION PEER GROUP COMMITTEE

Register of Deeds Stamp & File Number

4. Lot No. , Recorded Plat
5. Private Claims

Grid table with columns A-M and rows 2-13. A black dot is present in the cell at row 12, column K.

I, William L. Roskelly in a field survey on November 10, 1993, do hereby certify that under requirements of P.A. 74, Michigan P.A. of 1970, the corner points mentioned in lines 1 and 2 above were in conformance with regulations and rules therefore as required in the current manual of survey instructions of the United States Department of the Interior, Bureau of Land Management or by a decree of a Court of Law and/or that the corner points mentioned in lines 3, 4 and 5 above were in conformance with the rules of the Michigan Board of Land Surveyors or by a Decree of a Court of Law; established, re-established, monumented, re-monumented, recovered, found as expressed below.

NOTE: Not more than 4 corners, all in the same town and range, may be recorded on this certificate.

A. Description of original monument and accessories and/or subsequent restoration:


No G.L.O. Witnesses remain
LCRC L. 19990 P. 619 on 1/4/1978 Richard Swanson found a 1" iron pipe and recorded the following witnesses:
N.W. 29.19 ft. to horizontal spike in S.W. side of 12" Elm.
N.-N.E. 16.89 ft. " " " " S.E. " " 19" Ash.
N.E. 46.14 ft. " corner fence post.
N.E. 28.49 ft. " horizontal spike in N. side of 8" Elm.
W. 21.55 ft. " " " " S. side of Guard Post.

B. Description of corner evidence found and/or method applied in restoring or reestablishing corner:

Found 1" iron pipe
Verified section corner thru recorded document Rc. 571 L. 19990, Pg. 619,620
N.W. 29.19 spike in S.W. side 12" Elm meas. 29.32 #2 below
N.N.E. 16.89 spike in S.E. side 19" Ash meas. 17'± to tree
N.E. 46.14 corner fence post meas. 46.14±

C. Description of monument for corner and accessories established to perpetuate locating the position of the corner:

K-12: Section corner 35 & 36, T.3 S.R.8 E. Found 1" iron pipe. The selected location is accepted by the Contractor and is generally accepted by professional surveyors as the best available evidence of the position of the original corner. Placed Wayne Co. brass disk with license #10705.
Set WCR Tag southerly face 22" Ash N. 35° E. dist. 15.59
Set WCR Tag West face 12" Elm S. 20° E. dist. 29.42
Set WCR Tag West face 24" Cluster Elm N. 30° W. dist. 29.20
Set WCR Tag North face 12" Elm S. 70° W. dist. 87.90

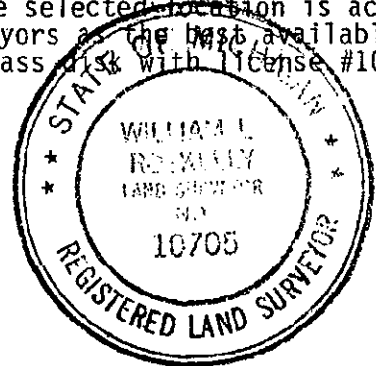

Signed by [Signature] Date November 9, 1993
Surveyor's Michigan License No. 10705

Handwritten initials: 2K 11KD

Vertical stamp: RECEIVED... 93 DEC -7 PM 2:11