

SURVEY & REMONUMENTATION

APR 25 1995

RC 1575

\$ 16.00 MISCELLANEOUS RECORDING
 28 DEC 94 8:23 A.M. RECEIPT# 100
 REGISTERED
 REGISTER OF DEEDS
 WAYNE COUNTY, MI

COMMISSION

LAND CORNER RECORDATION CERTIFICATE

Filing Requirement of Act 74, Mich. P.A. 1970

For corners in

WAYNE
 (County)

Located In:

Corner Code #

- 1. Public Land Survey T 3 S R 8 E
- 2. Property Controlling S ___ T ___ R ___
- 3. Miscellaneous S ___ T ___ R ___
- Property in Sec. S ___ T ___ R ___

K-13

Page 1 of 2

L127800PA069

Compliance with
 ACT 345, P.A. 1990

APPROVED ON: 12-8-94
 WAYNE COUNTY REMONUMENTATION
 PEER GROUP COMMITTEE

Register of Deeds Stamp & File Number

RC 1575

- 4. Lot No. _____, Recorded Plat _____
- 5. Private Claims _____

	A	B	C	D	E	F	G	H	I	J	K	L	M
2	6		5		4		3		2		1		
3													
4	7		8		9		10		11		12		
5													
6	18		17		16		15		14		13		
7													
8	19		20		21		22		23		24		
9													
10	30		29		28		27		26		25		
11													
12	31		32		33		34		35		36		
13													

I, William L. Roskelly in a field survey on November 1, 1994, do hereby certify that under requirements of P.A. 74, Michigan P.A. of 1970, the corner points mentioned in lines 1 and 2 above were in conformance with regulations and rules therefore as required in the current manual of survey instructions of the United States Department of the Interior, Bureau of Land Management or by a decree of a Court of Law and/or that the corner points mentioned in lines 3, 4 and 5 above were in conformance with the rules of the Michigan Board of Land Surveyors or by a Decree of a Court of Law; established, re-established, monumented, re-monumented, recovered, found as expressed below:

NOTE: Not more than 4 corners, all in the same town and range, may be recorded on this certificate.

A. Description of original monument and accessories and/or subsequent restoration:
K-13 South corner common to Sections 35 and 36, T.3 S.,R.8 E.

G.L.O. (1830's) J. Wampler set corner witnesses aB. 012, S2W84 (gone), aB0 30 N 85 E 69 (gone).
 W.P.A. (1930's) found iron witnesses N.W. 54.93 12" cherry (gone)
 S.W. 63.30 12" Cherry (gone), N.E. 38.77 Road sign post (gone). Also measured E. 413.52 to monument T.4 S,R.8 E. (measured 413.41).
 L.C.R.C. L. 18401, P. 84 RC #227 4/16/73 Robert A. Campbell found an iron in road box. Witnesses: N.E. 69.12 Twin 6" Oak (gone). S.W. 48.11 fence post found measured 48±, post damaged. (continued on sheet 2)

B. Description of corner evidence found and/or method applied in restoring or reestablishing corner:

K-13 South corner common to Sections 35 and 36, T.3 S.,R.8 E.
 Found an iron pipe in a monument box 1' below asphalt at centerline of Bemis Road. Compared field measurements with W.P.A. Survey. K-13 to J-13 W.P.A. = 2692.18 measured = 2692.11
 Line K-13 to L-13 to K-13 to J-13 W.P.A. = 270° 00' 00" measured = 270° 00' 14".
 J-13 to N.W. corner Section 2, T.4 S.R.8 E. W.P.A. = 425.38 measured = 425.41
 K-13 to N.E. corner Section 2, T.4 S.R.8 E. W.P.A. = 413.52 measured = 413.41
 Further support for corner location provided by W.C.R.C. bronze disk #50-183 Recorded = S.W. 48.11 (damaged post) measured = 48±.
 Roskelly, Jakobson & Assoc. N. 70° W. 62.51 center bolt of five hydrant = 62.51 measured = 62.53

C. Description of monument for corner and accessories established to perpetuate locating the position of the corner:


K-13 South corner common to Sections 35 and 36, T.3 S.,R.8 E.
 Found an iron pipe in a monument box 1' below asphalt at the centerline of Bemis Road. The selected location is accepted by the Contractor and is generally accepted by professional surveyors as the best available evidence of the position of the original corner.
 Set W.C.R. tag & nail East face 18" twin Oak N. 20° E. dist. = 69.54
 Set nail & W.C.R. tag north face mail box post S. 50° E. dist. = 37.53
 Found W.C.R.S. B.M. disk #50-183 S. 53° W. dist. = 55.37
 Found Top bolt hydrant N. 60° W. dist. 62.53
 Placed Wayne County Remonumentation brass marker and cap #10705

2R
 14-D
 MISC

Signed by William L. Roskelly

Date 12/27/94

Surveyor's Michigan License No. 10705

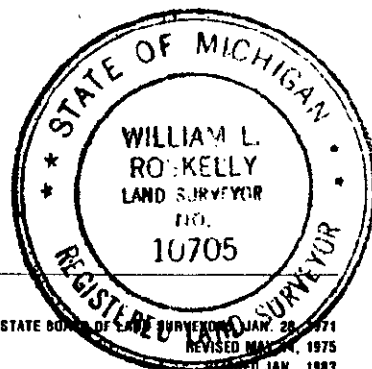

FORM APPROVED BY MICHIGAN STATE BOARD OF LAND SURVEYORS JAN. 28, 1971
 REVISED MAR. 24, 1975
 ADOPTED JAN., 1983

LAND CORNER RECORDATION CERTIFICATE
Filing Requirement of Act 74, Mich. P.A. 1970

LI27806PA070

For corners in

WAYNE
 (County)

Located In:

Corner Code #

- | | | |
|---------------------------------------|---------------------------|--------------------|
| 1. Public Land Survey | T <u>3</u> S R <u>8</u> E | <u>K-13</u> |
| | T _____ R _____ | _____ |
| | T _____ R _____ | _____ |
| | T _____ R _____ | _____ |
| 2. Property Controlling
In Section | S _____ T _____ R _____ | <i>Page 2 of 2</i> |
| | S _____ T _____ R _____ | |
| 3. Miscellaneous
Property in Sec. | S _____ T _____ R _____ | |
| | S _____ T _____ R _____ | |

Compliance with
 ACT 345, P.A. 1990

APPROVED ON: 12-8-94 *[Signature]*
 WAYNE COUNTY REMONUMENTATION
 PEER GROUP COMMITTEE

Register of Deeds Stamp & File Number

4. Lot No. _____, Recorded Plat _____
 5. Private Claims _____

	A	B	C	D	E	F	G	H	I	J	K	L	M
2	6	5	4	3	2	1							
3													
4	7	8	9	10	11	12							
5													
6	18	17	16	15	14	13							
7													
8	19	20	21	22	23	24							
9													
10	30	29	28	27	26	25							
11													
12	31	32	33	34	35	36							
13													

I, _____, in a field survey on _____, 19____, do hereby certify that under requirements of P.A. 74, Michigan P.A. of 1970, the corner points mentioned in lines 1 and 2 above were in conformance with regulations and rules therefore as required in the current manual of survey instructions of the United States Department of the Interior, Bureau of Land Management or by a decree of a Court of Law and/or that the corner points mentioned in lines 3, 4 and 5 above were in conformance with the rules of the Michigan Board of Land Surveyors or by a Decree of a Court of Law; established, re-established, monumented, re-monumented, recovered, found as expressed below:


NOTE: Not more than 4 corners, all in the same town and range, may be recorded on this certificate.

A. Description of original monument and accessories and/or subsequent restoration:

S.W.55.42 W.C.R.C. B.M. (measured 55.37), N.W. 46.80 Road sign, E. 413.71 iron in road box (measured 413.41)
 L.C.R.C. L. 18444, P. 74 & 75 CS #616 6/1/73 William B. Lokey found a monument in mon. box. Roskelly, Jakobson & Assoc. 8/26/76 found an iron in monument box witnesses N. 70° W. 62.51 center of fire hydrant (measured 62.53) N. 45° W. 46.75 (not verified), N. 25° E. 69.00 nail in a 10" Red Oak (gone). No C.S. on file at the Wayne County Register of Deeds.

B. Description of corner evidence found and/or method applied in restoring or reestablishing corner:

C. Description of monument for corner and accessories established to perpetuate locating the position of the corner:

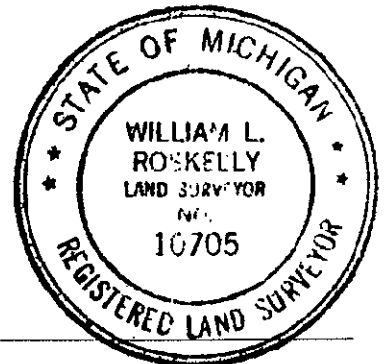

Signed by *William L. Roskelly*
 Surveyor's Michigan License No. 10705

Date 12/27/94