

FEB 28 1994

LAND CORNER RECORDATION CERTIFICATE  
Filing Requirement of Act 74, Mich. P.A. 1970

For corners in COMMISSION  
Wayne  
(County)

	Located In:	Corner Code #
1. Public Land Survey	T <u>3S</u> R <u>8 E.</u>	<u>L-3</u>
	T _____ R _____	_____
	T _____ R _____	_____
	T _____ R _____	_____
2. Property Controlling in Section	S _____ T _____ R _____	_____
	S _____ T _____ R _____	_____
3. Miscellaneous Property in Sec.	S _____ T _____ R _____	_____
	S _____ T _____ R _____	_____

Compliance with  
ACT 345, P.A. 1990  
APPROVED ON: 12-7-93  
WAYNE COUNTY REMONUMENTATION  
PEER GROUP COMMITTEE

Register of Deeds Stamp & File Number

4. Lot No. \_\_\_\_\_, Recorded Plat \_\_\_\_\_  
5. Private Claims \_\_\_\_\_

	A	B	C	D	E	F	G	H	I	J	K	L	M
2	6	5	4	3	2	1							
3													
4	7	8	9	10	11	12							
5													
6	18	17	16	15	14	13							
7													
8	19	20	21	22	23	24							
9													
10	30	29	28	27	26	25							
11													
12	31	32	33	34	35	36							
13													

I, William L. Roskelly in a field survey on November 2, 1993, do hereby certify that under requirements of P.A. 74, Michigan P.A. of 1970, the corner points mentioned in lines 1 and 2 above were in conformance with regulations and rules therefore as required in the current manual of survey instructions of the United States Department of the Interior, Bureau of Land Management or by a decree of a Court of Law and/or that the corner points mentioned in lines 3, 4 and 5 above were in conformance with the rules of the Michigan Board of Land Surveyors or by a Decree of a Court of Law; established, re-established, monumented, re-monumented, recovered, found as expressed below:

**NOTE: Not more than 4 corners, all in the same town and range, may be recorded on this certificate.**

A. Description of original monument and accessories and/or subsequent restoration:


No G.L.O. Witnesses remain  
RC L. 24450, P. 238 on 11/14/1989 Arthur Crossman found a cross in concrete roadway and recorded the following witnesses:  
N.E. 129.06 S.W. corner of house  
S. 83.28 fence post  
S.W. 89.72 edge of culvert  
N.W. 83.88 edge of culvert

B. Description of corner evidence found and/or method applied in restoring or reestablishing corner:

Found monument box with 2" steel bar - bolt in west bound lane  
Also verified section corner thru document L. 24450, Pg. 238  
13.35 North of North edge of raised median meas. 13.35±  
N. 65° E. bolt hydrant 81.36 meas. 81.23 see #1 below  
N. 5° W. 85.44 PK nail E. face 15" tree meas. 85.40 see #6 below

C. Description of monument for corner and accessories established to perpetuate locating the position of the corner:

L-3: Section corner 1 & 12 T.3 S.R.8 E. Found monument box with 2" steel bar-bolt. The selected location is accepted by the Contractor and is generally accepted by professional surveyors as the best available evidence of the position of the original corner.  
Placed Wayne Co. brass disk with license #10705.  
Top bolt hydrant N. 60° E. dist. 81.23  
Set steel bar in seam of conc. median S. 45° E. dist. 30.35  
Set P.K. Tag #10705 in seam of conc. median S. 60° W. dist. 21.40  
Set P.K. & Tag 10705 in seam of west bound lane N. 80° W. dist. 55.89  
Set WCR Tag West face 10" Tree N. 16° W. dist. 58.58  
Set WCR Tag East face 15" Tree N. 10° E. dist. 84.92  
Set PK Tag 10705 top curb in seam N. 60° W. dist. 59.00

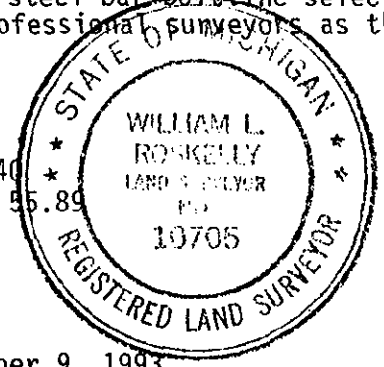

Signed by William L. Roskelly Date November 9, 1993

Surveyor's Michigan License No. 10705

2K 11KD

FOREST & WILDLIFE  
 RECORDS SECTION  
 93 DEC -7 PM 2:11