

LI29367PA019

\$ 7.00 DEED
30 DEC 96 1:49 P.M. RECEIPT# 468
RECORDED
FOREST E. YOUNGBLOOD, REGISTER OF DEEDS
WAYNE COUNTY, MI

LAND CORNER RECORDATION CERTIFICATE
Filing Requirement of Act 74, Mich. P.A. 1970

For corners in

Wayne, Van Buren Twp. Located In: Corner Code #
(County)

1. Public Land Survey	T <u>3S.</u> R <u>8E.</u>	<u>L-5</u>
	T <u> </u> R <u> </u>	<u> </u>
	T <u> </u> R <u> </u>	<u> </u>
	T <u> </u> R <u> </u>	<u> </u>
2. Property Controlling in Section	S <u> </u> T <u> </u> R <u> </u>	<u> </u>
	S <u> </u> T <u> </u> R <u> </u>	<u> </u>
3. Miscellaneous Property in Sec.	S <u> </u> T <u> </u> R <u> </u>	<u> </u>
	S <u> </u> T <u> </u> R <u> </u>	<u> </u>

\$ 4.00 REMONUMENTATION

Compliance with
ACT 345, P.A. 1990

APPROVED ON: 12-30-96 *RFJ*
WAYNE COUNTY REMONUMENTATION
PEER GROUP COMMITTEE

Register of Deeds Stamp & File Number

4. Lot No. _____, Recorded Plat _____
5. Private Claims _____

I, William L. Roskelly, in a field survey on Dec 16, 19 96 do hereby state that under requirements of P.A. 74, Michigan P.A. of 1970, the corner points mentioned in lines 1 and 2 above were in conformance with regulations and rules therefore as required in the current manual of survey instructions of the United States Department of the Interior, Bureau of Land Management or by a decree of a Court of Law and/or that the corner points mentioned in lines 3, 4 and 5 above were in conformance with the rules of the Michigan Board of Land Surveyors or by a Decree of a Court of Law; established, re-established, monumented, recovered, found as expressed below:

A	B	C	D	E	F	G	H	I	J	K	L	M
1												
2	6	5	4	3	2	1						
3												
4	7	8	9	10	11	12						
5												
6	18	17	16	15	14	13						
7												
8	19	20	21	22	23	24						
9												
10	30	29	28	27	26	25						
11												
12	31	32	33	34	35	36						
13												

NOTE: Not more than 2 corners, all in the same town and range, may be recorded on this certificate.

A. Description of original monument and accessories and/or subsequent restoration:


L-5) North corner section 13, T.3 S., R.8 E., Van Buren Township

G.L.O. (1830's) J. Wampler set corner post, witnesses: Lynn 19 SW 45 W 4 (gone), B.O. 22 S 45 E 4 (gone).
W.P.A. (1930's) Set an iron, witnesses: NE 32.56' nail in a 5" Cherry stump (gone), SW 85.35' E. fence post (gone), NW 53.14' fence post (gone).
W.C.R.C. April 1970 found an iron, witnesses: NE 32.56' nail in a 5" Cherry stump (gone), SW 85.35' E. fence post (gone), NW 53.14' fence post (gone).
William Carlson 3/22/72 CS 125 L. 18022, P. 44 found an iron pipe, no witnesses.

B. Description of corner evidence found and/or method applied in restoring or reestablishing corner:

L-5) North corner section 13, T.3 S., R.8 E., Van Buren Township

Found 2" iron pipe at large rock in a field.
Verified the corner location by comparing field measurements with W.P.A. survey:
Distance L-5 to K-5 Record = 2765.88', Measured = 2765.03'
Distance K-5 to K-6 Record = 2692.31', Measured = 2692.73'
Angle line K-5 & L-5 to K-5 & K-6 Record = 87° 29' 55", Measured = 87° 14' 22"

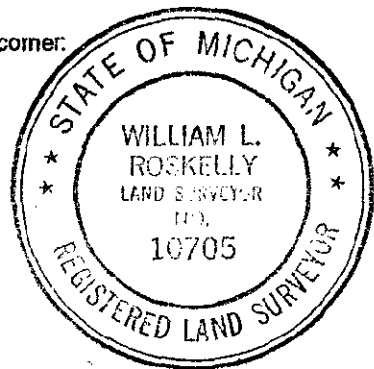

C. Description of monument for corner and accessories established to perpetuate locating the position of the corner:

L-5) North corner section 13, T.3 S., R.8 E., Van Buren Township

Found 2" iron pipe at large rock in a field.
The selected location is accepted by the contractor and is generally accepted by professional surveyors as the best available evidence of the position of the corner.
Witnesses:
N. 33° E. 39.13' set nail and WCR tag N. face 4" Poplar.
S. 23° E. 8.81' set nail and WCR tag E. face 4" Box Elder.
S. 62° W. 21.30' set nail and WCR tag N. face 24" Box Elder.
N. 13° W. 25.84' set nail and WCR tag E. face 24" Box Elder.

Signed by William L. Roskelly
Surveyor's Michigan License No. 10705

Date 12-30-96

*42
70
RFJ*