

**LAND CORNER RECORDATION CERTIFICATE**  
 Filing Requirement of Act 74, Mich. P.A. 1970

129357PA018  
 \$ 4.00 REMONUMENTATION  
 DEC 96 1:49 P.M. RECEIPT# 458  
 RECORDED  
 FOREST E. YOUNGBLOOD, REGISTER OF DEEDS  
 WAYNE COUNTY, MI  
 \$ 7.00 DEED


For corners in  
Wayne, Van Buren Twp. Located In: \_\_\_\_\_ Corner Code # \_\_\_\_\_  
 (County)

1. Public Land Survey	T <u>3S.</u> R <u>8E.</u>	<u>L-7</u>
	T _____ R _____	_____
	T _____ R _____	_____
	T _____ R _____	_____
2. Property Controlling in Section	S _____ T _____ R _____	_____
	S _____ T _____ R _____	_____
3. Miscellaneous Property in Sec.	S _____ T _____ R _____	_____
	S _____ T _____ R _____	_____

Compliance with  
 ACT 345, P.A. 1990  
 APPROVED ON: 12-30-96  
 WAYNE COUNTY REMONUMENTATION  
 PEER GROUP COMMITTEE  
 Register of Deeds Stamp & File Number

4. Lot No. \_\_\_\_\_, Recorded Plat \_\_\_\_\_  
 5. Private Claims \_\_\_\_\_


I, William L. Roskelly, in a field survey on Dec 20, 19 96, do hereby state that under requirements of P.A. 74, Michigan P.A. of 1970, the corner points mentioned in lines 1 and 2 above were in conformance with regulations and rules therefore as required in the current manual of survey instructions of the United States Department of the Interior, Bureau of Land Management or by a decree of a Court of Law and /or that the corner points mentioned in lines 3, 4 and 5 above were in conformance with the rules of the Michigan Board of Land Surveyors or by a Decree of a Court of Law; established, re-established, monumented, recovered, found as expressed below.

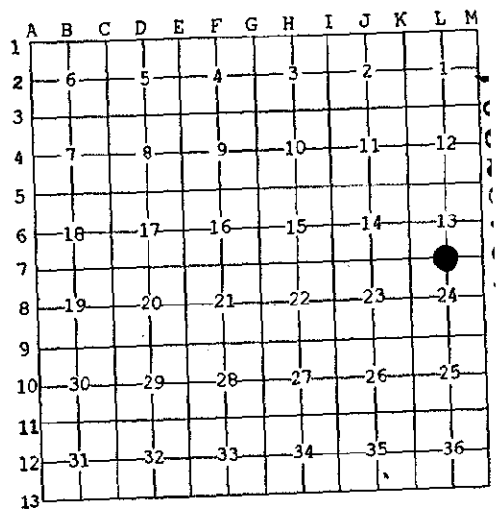

NOTE: Not more than 2 corners, all in the same town and range, may be recorded on this certificate.

A. Description of original monument and accessories and/or subsequent restoration:  
L-7) South corner section 13, T.3 S., R.8 E., Van Buren Township  
 G.L.O. (1830's) J. Wampler set temporary post, no witnesses.  
 W.P.A. (1930's) Found a stone, witnesses: N 42.19' 6" Twin Maple (gone), SE 60.60' 16" Apple (gone), S 48.62' 10" W. Walnut (gone), SW 90.60' Ed. pole (gone), SW 74.50' Mon. (gone)  
 Widrig O'Neill & Associates 4/25/72 found a monument, witnesses: Fence corner N'ly 34.05' (gone), D.E. pole N.E.'ly 42.7' (gone), MBT pole S.E. 'ly 65.6' (gone).  
 McNeely & Lincoln Associates, Inc. 11/10/94 CS 2127 L. 27796, P. 902 found an iron in a box, no witnesses.

B. Description of corner evidence found and/or method applied in restoring or reestablishing corner:  
L-7) South corner section 13, T.3 S., R.8 E., Van Buren Township  
 Found a P.K. nail in a steel cased concrete monument in a mon. box in I-94 ROW (grass).  
 Verified corner location by comparing field measurements with W.P.A. survey:  
 Distance L-7 to M-7 Record = 2681.07' Measured = 2681.24'  
 Distance M-7 to M-8 Record = 2677.34' Measured = 2677.60'  
 Distance M-7 to M-6 Record = 2656.53' Measured = 2656.72'  
 Angle line M-7 & L-7 to M-7 & M-8 Record = 93° 06' 40" Measured = 93° 04' 33"

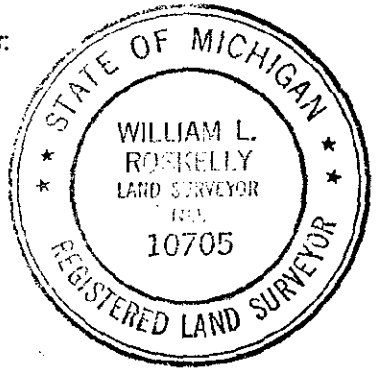

C. Description of monument for corner and accessories established to perpetuate locating the position of the corner:  
L-7) South corner section 13, T.3 S., R.8 E., Van Buren Township  
 Found a P.K. nail in a steel cased concrete monument in a mon. box in I-94 ROW (grass).  
 The selected location is accepted by the contractor and is generally accepted by professional surveyors as the best available evidence of the position of the corner.  
 WITNESSES:  
 N. 63° E. 45.55' set P.K. nail and WCR tag in eastbound shoulder of I-94, S. 10° E. 114.59' found P.K. nail and tag # 21563 E. face power pole, S. 48° W. 147.71' found P.K. nail and tag # 21563 N.W. face power pole, N. 48° W. 34.89' set P.K. nail and WCR tag in eastbound shoulder of I-94.

Signed by William L. Roskelly  
 Surveyor's Michigan License No. 10705

Date 12-30-96

4R  
 70  
 JRS