

LAND CORNER RECORDATION CERTIFICATE
Filing Requirement of Act 74, Mich. P.A. 1970

\$ 10.00 DEED
30 DEC 96 1:49 P.M. RECEIPT# 488
RECORDED
FOREST E. YOUNGBLOOD, REGISTER OF DEEDS
WAYNE COUNTY, MI

For corners in

Wayne, Van Buren Twp.
(County)

Located in:

Corner Code #

1. Public Land Survey	T	3S.	R	8E.	M-6
	T		R		
	T		R		
	T		R		
2. Property Controlling in Section	S		T	R	
	S		T	R	
3. Miscellaneous Property in Sec.	S		T	R	
	S		T	R	

\$ 4.00 REMONUMENTATION

LI29857PA029

Compliance with
ACT 345, P.A. 1990

APPROVED ON: 12-30-96
WAYNE COUNTY REMONUMENTATION
PEER GROUP COMMITTEE

Register of Deeds Stamp & File Number

4. Lot No. _____, Recorded Plat _____
5. Private Claims _____

I, William L. Roskelly, in a field survey on Dec 20, 1996 do hereby state that under requirements of P.A. 74, Michigan P.A. of 1970, the corner points mentioned in lines 1 and 2 above were in conformance with regulations and rules therefore as required in the current manual of survey instructions of the United States Department of the Interior, Bureau of Land Management or by a decree of a Court of Law and /or that the corner points mentioned in lines 3, 4 and 5 above were in conformance with the rules of the Michigan Board of Land Surveyors or by a Decree of a Court of Law; established, re-established, monumented, recovered, found as expressed below:

NOTE: Not more than 2 corners, all in the same town and range, may be recorded on this certificate.

	A	B	C	D	E	F	G	H	I	J	K	L
1												
2	6		5		4		3		2		1	
3												
4	7		8		9		10		11		12	
5												
6	18		17		16		15		14		13	
7												
8	19		20		21		22		23		24	
9												
10	30		29		28		27		26		25	
11												
12	31		32		33		34		35		36	
13												

A. Description of original monument and accessories and/or subsequent restoration:


M-6 East corner section 13, T.3 S., R.8 E., Van Buren Township

G.L.O. (1830's) J. Wampler set corner post, witnesses: ABO 24 N 71 W 81 (gone), AWO20 S 31, E 46 (gone).
W.P.A. (1930's) Found an iron, witnesses: N. 1021' +/- iron (gone), NE 32.26' nail in a 4" Oak (gone), SE 86.93' nail in a 6" Cherry (gone), SW 38.55' nail in Tel. pole (gone), NW 87.23' nail in a 12" Oak (gone). W.C.R.C. June 1970 found a steel rod in box (no lid) w/punch mark, witnesses: NE 124.20' nail in M.B.T. pole (gone), W. 34.79' M.S.H.D. nail and tag in an M.B.T. pole (gone), NW 87.08' to SE building corner #10350 (M=87.09'). Glenn R. Hobgood 4/17/79 set a 1/2" iron with copper clad disc type head, witnesses: N. 50° E. 15.47' Stenciled Sta. '+' mark (101+10) (gone), N. 75° E. 23.19' P.K. nail & cap in bridge sidewalk (gone), S. 55° W. 29.42' P.K. nail & cap in bridge sidewalk (gone), N. 55° W. 26.75' Wayne County B.M. (gone), (over)

B. Description of corner evidence found and/or method applied in restoring or reestablishing corner:

M-6 East corner section 13, T.3 S., R.8 E., Van Buren Township

Found a steel bar in a monument box at Hannan Road (pavement).
Verified corner location by comparing W.P.A. survey with field measurements:
M-6 to M-5 Record = 2652.59' Measured = 2652.61'
M-6 to M-7 Record = 2656.53' Measured = 2656.72'
Angle line M-6 & M-5 to M-6 & M-7 Record = 179°-57'-20" Measured = 179°-58'-01"
Measured South 1597.60' to A-7 Romulus Township.
NOT A COMMON CORNER.

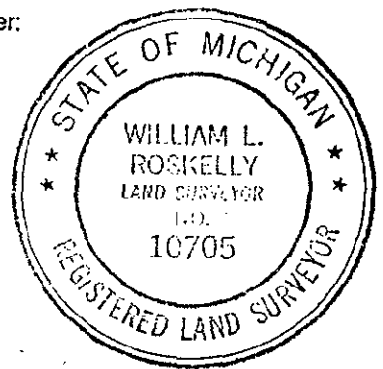

C. Description of monument for corner and accessories established to perpetuate locating the position of the corner:

M-6 East corner section 13, T.3 S., R.8 E., Van Buren Township

Found a steel bar in a monument box at Hannan Road (pavement).
The selected location is accepted by the contractor and is generally accepted by professional surveyors as the best available evidence of the position of the corner.

Witnesses:
N. 62° E. 30.86' set P.K. nail and WCR tag top post guard rail.
S. 30° W. 31.32' set P.K. nail and tag #10705 in asphalt.
N. 45° W. 87.09 (R=87.08) found S.E. house corner #10350 W.C.R.C. witness.
N. 18° W. 59.76' set P.K. nail and WCR tag top post guard rail.

Signed by William L. Roskelly
Surveyor's Michigan License No. 10705

Date 12-30-96

4K
10C
D.D.

M-6 East corner section 13, T.3 S., R.8 E., Van Buren Township (Continued)
N. 10.0' Pgmt joint N. end of bridge deck (gone)

29367 pg C29 1/2