

RC 1438

LI27794PA302

LAND CORNER RECORDATION CERTIFICATE

Filing Requirement of Act 74, Mich. P.A. 1970

M-01 Page 1

For corners in

Wayne

Located in: Sumpter Corner Code

County

- 1. Public Land Survey T 4 S R 8 E M-01
T 3 S R 8 E *Common To M-13 ✓*
- 2. Property Controlling S T R
in Section S T R *VAN BUREN Twp*
- 3. Miscellaneous S T R
Property In Sec. S T R
- 4. Lot No. _____, Recorded Plat _____
- 5. Private Claims _____

Compliance with ACT 345, P.A. 1990

APPROVED ON: 12/9/94 *WCD*
WAYNE COUNTY REMONUMENTATION PEER GROUP COMMITTEE

Register of Deeds Stamp and File Number

A	B	C	D	E	F	G	H	I	J	K	L	M
2	6	5	4	3	2	1						
3												
4	7	8	9	10	11	12						
5												
6	18	17	16	15	14	13						
7												
8	19	20	21	22	23	24						
9												
10	30	29	28	27	26	25						
11												
12	31	32	33	34	35	36						
13												

RC 1438

I, Kenneth S. Wilkerson in a field survey on 12/7/1994 do hereby certify that under requirements of P.A. 74, Michigan P.A. of 1970, the corner points mentioned in lines 1 and 2 above were in conformance with regulations and rules therefore as required in the current manual of survey instructions of the United States Department of the Interior, Bureau of Land Management. or by a decree of a Court of Law and/or that the corner points mentioned in lines 3, 4 and 5 above were in conformance with the rules of the Michigan Board of Land Surveyors or by a Decree of a Court of Law, established, re-established, monumented, re-monumented, recovered, found as expressed below.

NOTE: Not more than 4 corners, all in the same town and range, may be recorded on this certificate.

A. Description of original monument and accessories and/or subsequent restorations:

01/01/1819 Wampler G.L.O. Set post
24" W. OAK N 60 W 17 LINKS (11.22')
8" ASH S 75 E 14 LINKS (9.24')

(Witnesses Continued on Back ...)

B. Description of corner evidence found and/or method applied in restoring or reestablishing corner:

FD. 5/8" I.P. IN IRON CLAD MON. LOCATED IN FLOOD PLAIN. OF HURON RIVER. LOCATED BY HAND HELD G.P.S. UNIT.

C. Description of monument for corner and accessories established to perpetuate locating the position of the corner:

12/17/1994 Wilkerson 21584 OHM Remon

INTERSECTION OF FENCES TO W., E., & S. & 20' S OF TRAIL SET W.C.R. WASHER ON CORNER.


- 6 SET P.K. NAIL N. FACE 14" BASEWOOD N70E 18.66'
- 7 SET P.K. NAIL E. FACE 10" MAPLE SSW 26.46'
- 8 SET P.K. NAIL 13" SCYAMORE S80W 10.36'
- 9 SET P.K. NAIL W. FACE 6" ELM N20W 21.48'

\$ 16.00 MISCELLANEOUS RECORDING
21 DEC 94 3:19 P.M. RECEIPT# 93A
RECORDED
FOREST E. YOUNG, JR., REGISTER OF DEEDS
WAYNE COUNTY, MI

We conclude that after careful study of the record documentation and field observations, that this corner is accepted as the best available evidence of the position of the original corner.

Signed by [Signature]
Drafted by Kenneth S. Wilkerson
Surveyor's Michigan License No. 21584

Date Dec 21 1994

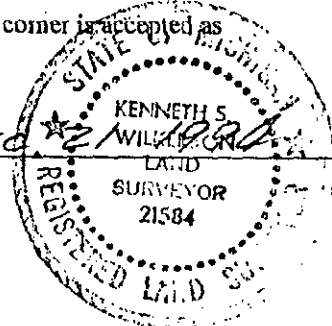

Richard, Illitz and McCliment, Inc. 34935 Schoolcraft Road Livonia, MI 48150

Z R
14 N - Misc

A. (Continued) Description of original monument and accessories and/or subsequent restorations:

01/01/1930

Wayne Co.
Bureau of
Taxation

Mon. set in place of iron

- 1 WEST 217 TO HURON RIVER
- 2 18" ELM N.W. 66.07'
- 3 MON NORTH 1028'
- 4 14" ELDER N.E. 58.32'
- 5 16" WALNUT EASTERLY 56.99'