

APR 05 1996

COMMISSION

LAND CORNER RECORDATION CERTIFICATE
 Filing Requirement of Act 74, Mich. P.A. 1970

\$ 4.00 REMONUMENTATION

\$ 7.00 DEED

19 DEC 95 11:55 A.M.

RECEI

A

RECORDED

FOREST E. YOUNGBLOOD, REGISTER
 WAYNE COUNTY, MI

EDS

For corners in

Wayne (County)	Located In: Van Buren	Corner Code #
1. Public Land Survey	T 3S.R8 E.	C-2
	T R	
	T R	
	T R	
	T R	
2. Property Controlling in Section	S T R	
	S T R	
3. Miscellaneous Property in Sec.	S T R	
	S T R	

SEQUENCE # 2
LIBER 28471 PAGE 676

Compliance with
 ACT 345, P.A. 1990

APPROVED ON: 12-12-95 [Signature]
 WAYNE COUNTY REMONUMENTATION
 PEER GROUP COMMITTEE

Register of Deeds Stamp & File Number **952713992**

4. Lot No. _____, Recorded Plat _____
 5. Private Claims _____

I, William Roskelly, in a field survey on December 5 1995 do hereby state that under requirements of P.A. 74, Michigan P.A. of 1970, the corner points mentioned in lines 1 and 2 above were in conformance with regulations and rules therefore as required in the current manual of survey instructions of the United States Department of the Interior, Bureau of Land Management or by a decree of a Court of Law and /or that the corner points mentioned in lines 3, 4 and 5 above were in conformance with the rules of the Michigan Board of Land Surveyors or by a Decree of a Court of Law; established, re-established, monumented, recovered, found as expressed below:

NOTE: Not more than 2 corners, all in the same town and range, may be recorded on this certificate.

	A	B	C	D	E	F	G	H	I	J	K	L	M
1													
2	6	●	5		4		3		2		1		
3													
4	7		8		9		10		11		12		
5													
6	18		17		16		15		14		13		
7													
8	19		20		21		22		23		24		
9													
10	30		29		28		27		26		25		
11													
12	31		32		33		34		35		36		
13													

A. Description of original monument and accessories and/or subsequent restoration:
C-2) East corner section 6, T.3 S.,R.8 E., Van Buren Township

G.L.O. (1830's) J. Wampler post is a Beech 23" in diameter, no corner set. W.P.A. (1930's) set a monument, witnesses: N.W. 34.95 14" Maple (gone), N.W. 53.97 14" Elm (gone), S.E. 49.25 C/L W. bound RR track (measured = 49.25), S.E. 35.30 telephone pole (gone), N.E. 44.23 24" Maple stump (gone), S.W. 35.09 cor. conc. batt. box (gone).
 WCRC (6/4/70) E. Johns found an iron witnesses: N.W. 37.78 M.B.T. pole (gone), S.W. 20.53 N.E. bolt base of RR signal (gone), S.E. 35.43 M.B.T. pole (gone). C.S. # 2073 L. 26370 P. 518 (4/19/79) Allen R. Rentschler no witnesses or corner description.
 No R.C.'s found on file at Wayne County Register of Deeds.

B. Description of corner evidence found and/or method applied in restoring or reestablishing corner:
C-2) East corner section 6, T.3 S.,R.8 E., Van Buren Township

Found a 1" iron pipe at the centerline of Denton Road (asphalt). Installed a monument box and cover. Verified corner location by comparing W.P.A. survey with field measurements:
 C-2 to C-3 Record = 2668.52 Measured = 2668.68
 C-3 to B-3 Record = 2690.04 Measured = 2689.85
 Angle line C-3 and B-3 to C-3 and C-2 Record = 89° 44' 10" Measured = 89° 44' 03"

Additional support:
 Corner checked to WPA witness, S.E. 49.25 C/L W. bound RR track (measured = 49.25).


C. Description of monument for corner and accessories established to perpetuate locating the position of the corner:
C-2) East corner section 6, T.3 S.,R.8 E., Van Buren Township

Found a 1" iron pipe at the centerline of Denton Road (asphalt). Installed a monument box and cover. The selected location is accepted by the contractor and is generally accepted by professional surveyors as the best available evidence of the position of the corner.
 WITNESSES:

Found a nail and tag OHM KSW #21584 N. face power pole N. 80° E. distance = 29.24, Found cross cut N.E. bolt RR signal S. 13° E. distance = 78.63, Found cross cut S.E. bolt RR signal S. 30° W. distance = 43.73, Found WPA witness, S.E. 49.25 C/L W. bound RR track (measured = 49.25) Set nail and WCR tag South face power pole N. 60° W. distance = 25.16
 Placed Wayne County Remonumentation brass marker and cap #10705

Signed by William Roskelly
 Surveyor's Michigan License No. 10705

Date 12-14-95

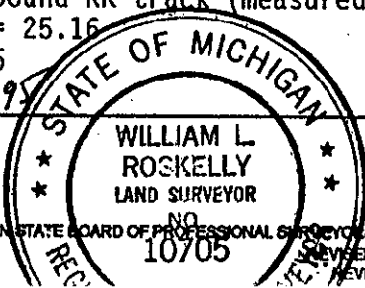

4R
7D