

RE-RECORD

SURVEY & REMONUMENTATION

LIBER 28477 PAGE 204

LAND CORNER RECORDATION CERTIFICATE

Filing Requirement of Act 74, Mich. P.A. 1970

APR 05 1996

B-05 Page 1

COMMISSION

Wayne County

Located in: Romulus Corner Code

- 1. Public Land Survey T 3 S R 9 E B-05
- 2. Property Controlling in Section S T R
- 3. Miscellaneous Property in Sec. S T R
- 4. Lot No. \_\_\_\_\_, Recorded Plat \_\_\_\_\_
- 5. Private Claims \_\_\_\_\_

LIBER 28647 PAGE 729

Compliance with ACT 345, P.A. 1990

APPROVED ON: 11-30-95  
WAYNE COUNTY REMONUMENTATION PEER GROUP COMMITTEE

Register of Deeds Stamp and File Number

I, Kenneth S. Wilkerson in a field survey on 11/07/1995 do hereby certify that under requirements of P.A. 74, Michigan P.A. of 1970, the corner points mentioned in lines 1 and 2 above were in conformance with regulations and rules therefore as required in the current manual of survey instructions of the United States Department of the Interior, Bureau of Land Management, or by a decree of a Court of Law and/or that the corner points mentioned in lines 3, 4 and 5 above were in conformance with the rules of the Michigan Board of Land Surveyors or by a Decree of a Court of Law, established, re-established, monumented, re-monumented, recovered, found as expressed below.

NOTE: Not more than 4 corners, all in the same town and range, may be recorded on this certificate.

A	B	C	D	E	F	G	H	I	J	K	L	M
2	6	5	4	3	2	1						
3												
4	7	8	9	10	11	12						
5												
6	18	17	16	15	14	13						
7												
8	19	20	21	22	23	24						
9												
10	30	29	28	27	26	25						
11												
12	31	32	33	34	35	36						
13												

A. Description of original monument and accessories and/or subsequent restorations:

01/01/1816 G.L.O. Set post  
10" W. OAK N 77 E 10 LINKS (6.66') (GONE)  
9" W. OAK N 24 W 33 LINKS (21.78") (GONE)

(Witnesses Continued on Back ...)

B. Description of corner evidence found and/or method applied in restoring or reestablishing corner:

Fd. 1/2" iron rod in mon box, 4" of rod exspd & bent over(no lid) in asph. pav't. @2'S&1.5'E of int. Dist to C-05 = 2628.55' (R), 2628.52' (M)

C. Description of monument for corner and accessories established to perpetuate locating the position of the corner:

11/07/1995 Wilkerson 21584 O.H.M. Remon  
SET W.C.R. REMON CAP & WASHER OVER FD. 1/2" IR. REPLACED  
5 W.C.R. TAG W/S P.P. S 33 E 81.58'  
8 W.C.R. TAG E/S P.P. N 13 W 71.83'  
9 W.C.R. TAG E/S P.P. S 23 W 66.88'  
10 W.C.R. TAG S. SIDE TWIN 20" COTTONWOOD N 67 W 73.81'  
14 DIST=2628.52 TO C-05

95273118  
9665634  
95 MAR -7 AM 11:27

\$ 10.00 DEED  
21 DEC 95 9:19 A.M. RECEIPT# 58  
RECORDED  
FOREST E. YOUNGBLOOD, REGISTER OF DEEDS  
WAYNE COUNTY, MI  
\$ 4.00 REMONUMENTATION


We conclude that after careful study of the record documentation and field observations, that this corner is accepted as the best available evidence of the position of the original corner.

Signed by [Signature] Date DEC 8 1995  
Drafted by Kenneth S. Wilkerson

Surveyor's Michigan License No. 21584

Orchard, Hiltz and McCliment, Inc. 34935 Schoolcraft Road Livonia, MI 48150

RECORDED TO ADD PEER GROUP DATE

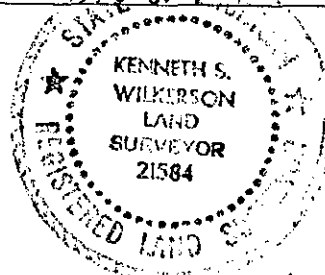

RE-RECORD

Handwritten initials and notes at the bottom right.

A. (Continued) Description of original monument and accessories and/or subsequent restorations:

01/01/1930

B/T

Fd. iron bar

- 1 NORTHWESTERLY 78.22' TEL. POLE(GONE)
- 2 18" MAPLE NE 37.69'(GONE)
- 3 ED. POLE SE 32.51' (GONE)
- 4 W.C.R. SIGN POST WESTERLY 20.34' (GONE)

LIBER 28477 PAGE 205

01/10/1980

Straub

26468

R.C. 7

Fd. mon. and verified location by using adjoining property descriptions and R.O.W. lines.

- 5 NAIL W. SIDE D. E. POLE S 35 E 81.47'
- 6 NAIL E. SIDE D. E. POLE S 17 W 75.65'
- 7 P. K. NAIL S. SIDE 4" TREES S 78 W 21.62' (GONE)
- 8 NAIL E. SIDE D.E. POLE N 18 W 71.83'

LIBER 28647 PAGE 730