

LAND CORNER RECORDATION CERTIFICATE

Filing Requirement of Act 74, Mich. P.A. 1970

APR 05 1996

C-02 Page 1

For corners in **COMMISSION**
Wayne

Located in: Romulus Corner Code

LIBER 28647 PAGE 727

- County _____
- | | | | | | | | |
|------------------------------------|---|-------|-------|---|-------|-------|-------|
| 1. Public Land Survey | T | 3 | S | R | 9 | E | C-02 |
| | T | _____ | _____ | R | _____ | _____ | _____ |
| | T | _____ | _____ | R | _____ | _____ | _____ |
| | T | _____ | _____ | R | _____ | _____ | _____ |
| 2. Property Controlling in Section | S | _____ | T | R | _____ | _____ | _____ |
| | S | _____ | T | R | _____ | _____ | _____ |
| 3. Miscellaneous Property In Sec. | S | _____ | T | R | _____ | _____ | _____ |
| | S | _____ | T | R | _____ | _____ | _____ |
4. Lot No. _____, Recorded Plat _____
5. Private Claims _____

Compliance with
ACT 345, P.A. 1990

APPROVED ON: 11-30-95 *DPJ*
WAYNE COUNTY REMONUMENTATION
PEER GROUP COMMITTEE

Register of Deeds Stamp and File Number

I, Kenneth S. Wilkerson in a field survey on 09/30/1995
do hereby certify that under requirements of P.A. 74, Michigan P.A. of 1970, the corner points mentioned in lines 1 and 2 above were in conformance with regulations and rules therefore as required in the current manual of survey instructions of the United States Department of the Interior, Bureau of Land Management, or by a decree of a Court of Law and/or that the corner points mentioned in lines 3, 4 and 5 above were in conformance with the rules of the Michigan Board of Land Surveyors or by a Decree of a Court of Law, established, re-established, monumented, re-monumented, recovered, found as expressed below.

NOTE: Not more than 4 corners, all in the same town and range, may be recorded on this certificate.

	A	B	C	D	E	F	G	H	I	J	K	L	M
2	6	•	5		4		3		2		1		
3													
4	7		8		9		10		11		12		
5													
6	18		17		16		15		14		13		
7													
8	19		20		21		22		23		24		
9													
10	30		29		28		27		26		25		
11													
12	31		32		33		34		35		36		
13													

A. Description of original monument and accessories and/or subsequent restorations:
01/01/1816 GLO

NO WITNESS
0 ON THIS DATE

(Witnesses Continued on Back ...)

B. Description of corner evidence found and/or method applied in restoring or reestablishing corner:

Fd. iron clad in field monument. DIST. TO C-1 2568.75(R) 2567.98'(R) DIST TO C-3 2605.82'(R) 2606.26'(R)

C. Description of monument for corner and accessories established to perpetuate locating the position of the corner:

09/30/1995 Wilkerson 21584 O.H.M. Remon

SET W.C.R. REMON CAP & WASHER OVER CORNER

- 9 N.E. COR. OF H.T. TOWER LEG S 5 W 33.89'
- 10 N.W. COR. OF H.T. TOWER LEG S 47 W 46.79'
- 11 NAIL IN W SIDE OF U.P. NORTH 2.11'
- 12 N.W. EDGE OF S.E. LEG S 21 W 66.00'
- 13 FD CAPPED IRON #12573, 0.71' S.E. OF MON.

96065633
 96273169 MAR -7 AM 11:27
 FOREST E. YOUNGBLOOD


\$ 10.00 DEED
21 DEC 95 9:19 A.M. RECEIPT# 5B
RECORDED
FOREST E. YOUNGBLOOD, REGISTER OF DEEDS
WAYNE COUNTY, MI
\$ 4.00 REMONUMENTATION

We conclude that after careful study of the record documentation and field observations, that this corner is accepted as the best available evidence of the position of the original corner.

Signed by *[Signature]* Date DEC 8 1995
 Drafted by Kenneth S. Wilkerson
 Surveyor's Michigan License No. 21584

Orchard, Hiltz and McCliment, Inc. 34935 Schoolcraft Road Livonia, MI 48150

RECORD TO ADD PEER GROUP DATE

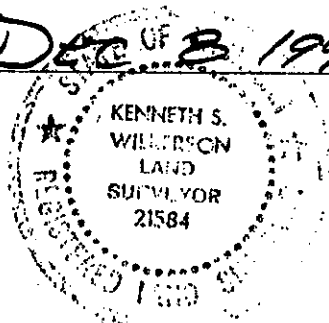

me
AP
10/2
K3

A. (Continued) Description of original monument and accessories and/or subsequent restorations:

LIBER 28477 PAGE 207

Fd. MON.

LIBER 28647 PAGE 728

01/01/1930

B/T

- 1 T.P. NORTHEAST 36.04'
- 2 F.P. EAST 0.73'
- 3 T.P. SOUTH 83.25'

05/10/1977

McMahon 4018

551

Fd. monument

- 4 M.B.T. POLE S 20 E 80.92'
- 5 NAIL IN 30" MAPLE TREE S 30 W 61.78'

05/20/1977

PITTS 10702 Wayne Co. 766

Fd. monument in East & West fence line

- 2 NEAR FACE OF FENCE LINE POST W. 1.08'
- 6 NAIL IN S SIDE 12" ELM N 70 W 60.38'
- 7 NEAREST EDGE OF STEEL BEAM (DE) S 30 W 31.79'

09/30/1993

J. WHITE SR. ELEC.

FD. IRON CLAD MON AGAINST E & W FENCE

- 8 N.E. CORNER OF H.T. TOWER LEG S 5 W 33.89'
- 9 N.W. CORNER OF H.T. TOWER LEG S 47 W 46.79'
- 10 NAIL W SIDE OF U.P. N 0 E 2.11'
- 11 N.W. EDGE OF S.E. LEG S 21 W 66.00'