

FEB 28 1994

LAND CORNER RECORDATION CERTIFICATE
Filing Requirement of Act 74, Mich. P.A. 1970

For corners in REMONUMENTATION

RC 1338

LI27042PA360

Compliance with
ACT 345, P.A. 1990

APPROVED ON: 12-15-93 *DPJ*
WAYNE COUNTY REMONUMENTATION
PEER GROUP COMMITTEE

Register of Deeds Stamp & File Number

| | | | |
|------------------------------------|---------|---------------------------|---------------|
| WAYNE | | | |
| County: | | | |
| ROMULUS TOWNSHIP #13 | | Located in: | Corner Code # |
| 1. Public Land Survey | | T <u>3 S</u> R <u>9 E</u> | <u>C-03</u> |
| | | T _____ R _____ | _____ |
| | | T _____ R _____ | _____ |
| | | T _____ R _____ | _____ |
| 2. Property Controlling in Section | S _____ | T _____ R _____ | _____ |
| | S _____ | T _____ R _____ | _____ |
| 3. Miscellaneous Property in Sec. | S _____ | T _____ R _____ | _____ |
| | S _____ | T _____ R _____ | _____ |

4. Lot No. _____, Recorded Plat _____
5. Private Claims _____

I, Kenneth S. Wilkerson, in a field survey on October 28, 19 93
do hereby certify that under requirements of P.A. 74, Michigan P.A. of 1970, the corner points mentioned in lines 1 and 2 above were in conformance with regulations and rules therefore as required in the current manual of survey instructions of the United States Department of the Interior, Bureau of Land Management or by a decree of a Court of Law and/or that the corner points mentioned in lines 3, 4 and 5 above were in conformance with the rules of the Michigan Board of Land Surveyors or by a Decree of a Court of Law, established, re-established, monumented, re-monumented, recovered, found as expressed below:

NOTE: Not more than 4 corners, all in the same town and range, may be recorded on this certificate.

A. Description of original monument and accessories and/or subsequent restoration:

C-03 Set Post - GLO - NO GLO WITNESSES REMAIN
Fd. Iron - B of T
Fd. Iron - L. 21149, P. 546 - 05/20/77

S 28.58 nail in W face 30" elm
SW 50.50 nail in NW face 24" poplar
SW 146.26 nail in NW face 28" poplar
NW 56.72 nail in SW face PP
N 38.10 nail in W face MBT P

B. Description of corner evidence found and/or method applied in restoring or reestablishing corner:

C-03 Fd. mon. in mon. box
Matches ties of L. 21149, P. 546

C. Description of monument for corner and accessories established to perpetuate locating the position of the corner:

Set WC remonumentation washer and OHM KSW 21584 cap on iron.

C-03 S 40 E 86.25 OHM tag in E face 9" elm
S 27 W 37.64 OHM tag in E face MBT P
N 20 W 68.92 OHM tag in E face PP
N 3 W 86.22 OHM tag in E face 12" elm


The selected location is accepted as the best evidence of the original corner.

| | | | | | | | | | | | | |
|----|----|----|----|----|----|----|---|---|---|---|---|---|
| A | B | C | D | E | F | G | H | I | J | K | L | M |
| 2 | 6 | 5 | 4 | 3 | 2 | 1 | | | | | | |
| 3 | | • | | | | | | | | | | |
| 4 | 7 | 8 | 9 | 10 | 11 | 12 | | | | | | |
| 5 | | | | | | | | | | | | |
| 6 | 18 | 17 | 16 | 15 | 14 | 13 | | | | | | |
| 7 | | | | | | | | | | | | |
| 8 | 19 | 20 | 21 | 22 | 23 | 24 | | | | | | |
| 9 | | | | | | | | | | | | |
| 10 | 30 | 29 | 28 | 27 | 26 | 25 | | | | | | |
| 11 | | | | | | | | | | | | |
| 12 | 31 | 32 | 33 | 34 | 35 | 36 | | | | | | |
| 13 | | | | | | | | | | | | |

RC 1338

93 DEC 15 PM 5:00
FOREST E. YOURBLOOD
REGISTER OF DEEDS
MICHIGAN STATE DEPT.

Signed by: *[Signature]*

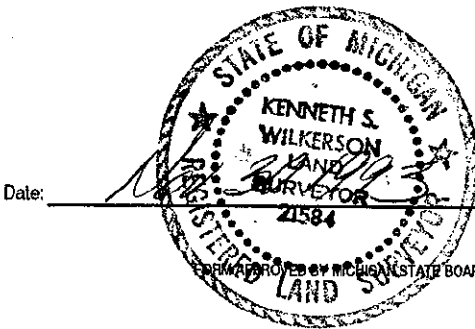

Date: _____

Drafted By: Kenneth S. Wilkerson
Surveyor's Michigan License No. 21584

Orchard, Hiltz & McCliment, Inc.
34935 Schoolcraft Road * Livonia, Michigan 48150 * Phone: (313) 522-6711

APPROVED BY MICHIGAN STATE BOARD OF LAND SURVEYORS, JAN. 28, 1971
REVISED MAY 14, 1975
REVISED JAN., 1983

2R
11KD