

SURVEY & REMONUMENTATION

LIBER 28477 PAGE 208

LAND CORNER RECORDATION CERTIFICATE

APR 05 1996

Filing Requirement of Act 74, Mich. P.A. 1970

C-04 Page 1

For COMMISSION

Wayne

Located in: Romulus Corner Code

LIBER 28647 PAGE 725

- 1. Public Land Survey T 3 S R 9 E C-04
- T R
- T R
- T R
- 2. Property Controlling S T R
- in Section S T R
- 3. Miscellaneous S T R
- Property in Sec. S T R
- 4. Lot No. _____, Recorded Plat _____
- 5. Private Claims _____

Compliance with ACT 345, P.A. 1990
 APPROVED ON: 11-30-95 *DBJ*
 WAYNE COUNTY REMONUMENTATION
 PEER GROUP COMMITTEE

Register of Deeds Stamp and File Number

A	B	C	D	E	F	G	H	I	J	K	L	M
2	6	5	4	3	2	1						
3												
4	7	8	9	10	11	12						
5												
6	18	17	16	15	14	13						
7												
8	19	20	21	22	23	24						
9												
10	30	29	28	27	26	25						
11												
12	31	32	33	34	35	36						
13												

I, Kenneth S. Wilkerson in a field survey on 11/07/1995 do hereby certify that under requirements of P.A. 74, Michigan P.A. of 1970, the corner points mentioned in lines 1 and 2 above were in conformance with regulations and rules therefore as required in the current manual of survey instructions of the United States Department of the Interior, Bureau of Land Management, or by a decree of a Court of Law and/or that the corner points mentioned in lines 3, 4 and 5 above were in conformance with the rules of the Michigan Board of Land Surveyors or by a Decree of a Court of Law, established, re-established, monumented, re-monumented, recovered, found as expressed below.

NOTE: Not more than 4 corners, all in the same town and range, may be recorded on this certificate.

A. Description of original monument and accessories and/or subsequent restorations:

- 01/01/1816 G.L.O. Set post
- 10" W.O. N 77 E 11 LINKS (7.26') (gone)
- 09" W.O. N 24 W 33 LINKS (21.78') (gone)

(Witnesses Continued on Back ...)

B. Description of corner evidence found and/or method applied in restoring or reestablishing corner:

FD. 1/2" IRON IN FIELD. DIST TO C-5 2633.16(R) 2634.74'(M) DIST TO C-3 2633.98'(R) 2631..77'(M)

C. Description of monument for corner and accessories established to perpetuate locating the position of the corner:

- 11/07/1995 Wilkerson 21584 O.H.M. Remon
- SET W.C.R.C. REMON AND WASHER OVER CORNER.
- 3 EAST 19.45' 14" ELM
- 8 N85W 26.99 O.H.M. TAG ON TREE
- 9 S80W 10.24' 8" ELM
- 10 S30E 15.38' SET IRON ROD.

\$ 10.00 DEED

\$ 4.00 REMONUMENTATION

21 DEC 95 9:20 A.M. RECEIPT# 5B
 RECORDED
 FOREST E. YOUNGBLOOD, REGISTER OF DEEDS
 WAYNE COUNTY, MI


95273120
 1995 MAR -7 AM 11:27
 96065632

We conclude that after careful study of the record documentation and field observations, that this corner is accepted as the best available evidence of the position of the original corner.

Signed by *[Signature]*
 Drafted by Kenneth S. Wilkerson
 Surveyor's Michigan License No. 21584

Date DEC 8 1995

Orchard, Hiltz and McCliment, Inc. 34935 Schoolcraft Road Livonia, MI 48150

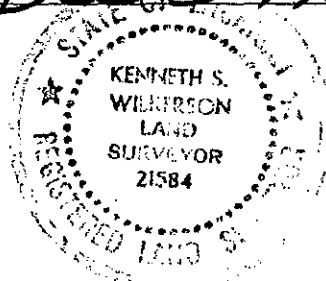

RERECORD TO ADD PEER GROUP DATE

w/c p.c. J.C.
AP 10/2

A. (Continued) Description of original monument and accessories and/or subsequent restorations:

LIBER 28477 PAGE 209

01/01/1930

B/T

Fd. 1" iron bar

- 1 20" SYCAMORE N.E. 129.59'
- 2 20" ELM S.W. 92.00'
- 3 14" ELM S. W. 19.10'
- 4 3" TWIN ASH N.W. 28.83'
- 5 4" ELM N. W. 38.16'

LIBER 28647 PAGE 726

01/01/1950

Det. Ed.

No mention of what was found

- 2 20" ELM S.W. 92.00'
- 3 14" ELM S. W. 19.10'
- 4 3" TWIN ASH N.W. 28.83'
- 5 4" ELM N. W. 38.16'

11/07/1973

Stonerock 13601

R. C.

No mention of what was found

- 4 NAIL IN CLUSTER OF ASH'S N 10 W 29.45'
- 6 NAIL IN 8" OAK N 20 E 7.50'
- 7 NAIL IN 10" OAK WEST 28.49'