

**SURVEY &
REMONUMENTATION**

RC 1445

LAND CORNER RECORDATION CERTIFICATE

LI27794PA316

APR 25 1995

Filing Requirement of Act 74, Mich. P.A. 1970

C-05 Page 1

For corner of **COMMISSION**

Wayne

Located in: Romulus Corner Code

County

1. Public Land Survey	T <u>3</u> S	R <u>9</u> E	C-05
	T _____	R _____	_____
	T _____	R _____	_____
	T _____	R _____	_____
2. Property Controlling In Section	S _____	T _____	R _____
	S _____	T _____	R _____
3. Miscellaneous Property In Sec.	S _____	T _____	R _____
	S _____	T _____	R _____
4. Lot No. _____, Recorded Plat _____			
5. Private Claims _____			

Compliance with
ACT 345, P.A. 1990

APPROVED ON: 12/9/94 W.C.D.
WAYNE COUNTY REMONUMENTATION
PEER GROUP COMMITTEE

Register of Deeds Stamp and File Number

	A	B	C	D	E	F	G	H	I	J	K	L	M
2	6	5	4	3	2	1							
3													
4	7	8	9	10	11	12							
5													
6	18	17	16	15	14	13							
7													
8	19	20	21	22	23	24							
9													
10	30	29	28	27	26	25							
11													
12	31	32	33	34	35	36							
13													

I, Kenneth S. Wilkerson in a field survey on 11/07/1994
do hereby certify that under requirements of P.A. 74, Michigan P.A. of 1970, the corner points mentioned in lines 1 and 2 above were in conformance with regulations and rules therefore as required in the current manual of survey instructions of the United States Department of the Interior, Bureau of Land Management, or by a decree of a Court of Law and/or that the corner points mentioned in lines 3, 4 and 5 above were in conformance with the rules of the Michigan Board of Land Surveyors or by a Decree of a Court of Law, established, re-established, monumented, re-monumented, recovered, found as expressed below.

NOTE: Not more than 4 corners, all in the same town and range, may be recorded on this certificate.

A. Description of original monument and accessories and/or subsequent restorations:

01/01/1816 G.L.O. Set post |
9" B Ash S 29 E 17 LINKS (11.22') (GONE)
16" W.O. S 81 E 187 LINKS (123.42') (GONE)

(Witnesses Continued on Back ...)

B. Description of corner evidence found and/or method applied in restoring or reestablishing corner:

Fd. 1/2" iron rod in mon. box w/cover in asph. pav't. @ 2'N of int. of cl's of Wick & Ozga Rds. C-05 to B-05 = 2628.55' (R), 2628.52' (M)

C. Description of monument for corner and accessories established to perpetuate locating the position of the corner:


11/07/1994 Wilkerson 21584 O.H.M. Remon
SET W.C.R. WASHER & CAP ON CORNER.
3 W.C.R. TAG N.E. SIDE 24" ASH S 63 E 76.24'
10 W.C.R. TAG E/S P.P. S 26 W 87.60'
11 W.C.R. TAG S. SIDE 10" ASH N 57 W 68.27'
12 W.C.R. TAG N.W./S P.P. N 59 E 45.65'

\$ 16.00 MISCELLANEOUS RECORDING
21 DEC 94 3:21 P.M. RECEIPT# 93A
RECORDED
FORREST E. YODanis, REGISTER OF DEED
WAYNE COUNTY, MI

We conclude that after careful study of the record documentation and field observations, that this corner is accepted as the best available evidence of the position of the original corner.

Signed by [Signature]
Drafted by Kenneth S. Wilkerson
Surveyor's Michigan License No. 21584
Orchard, Hiltz and McCliment, Inc. 34935 Schoolcraft Road Livonia, MI 48150

Date 12/9/94

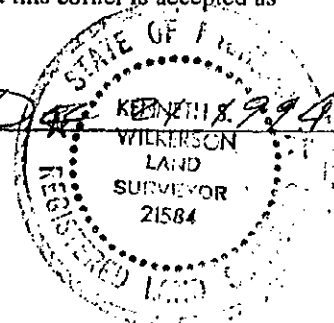

2R
14-N-MIS

A (Continued) Description of original monument and accessories and/or subsequent restorations:

01/01/1930	W.C.R.C.	B/T	Fd. iron bar
1	GUARD RAIL N. E. 23.73' (GONE)		
2	GAURD RAIL N. W. 15.43' (GONE)		
3	8" ASH S. E. 75.86'		
4	3" ASH S. E. 60.32' (GONE)		
5	12" OAK S. W. 106.05' (GONE)		
6	W.C.R. SIGN POST S. W. 20.43' (GONE)		
13	DIST = 2628.55' TO B-05		
01/01/1960	W.C.R.C.		Fd. monument
3	8" ASH S. E. 75.86'		
5	12" OAK S. W. 106.05'(GONE)		
7	M.B.T. N. W. 128.46' (GONE)		
8	M.B.T. N. E. 36.61' (GONE)		
07/27/1973	Fraus 17089	R. C.	Fd. 1/2" iron
3	18" ASH S 70 E 75.46'		
5	NAIL IN 15" OAK S 10 W 106.11' (GONE)		
8	NAIL IN POWER POLE N 50 E 36.86' (GONE)		
9	MEETERING BOX S 65 W 68.00' (GONE)		
11/07/1973	Stonerock 13601	R. C.	Fd. 1/2" iron, raised to surface
3	14" ASH S 30 E 75.45'		
5	NAIL IN 16" OAK S 20 W 106.20' (GONE)		

L127794PA317