

FEB 28 2000

SECTION

FILE DO NOT MAIL

LAND CORNER RECORDATION CERTIFICATE  
Filing Requirement of Act 74, Mich. P.A. 1970

For corners in


WAYNE (County)	Located In: CITY OF ROMULUS	Corner Code #
1. Public Land Survey	T 3 S R 9 E	C-8
	T _____ R _____	_____
	T _____ R _____	_____
	T _____ R _____	_____
2. Property controlling in Section	S _____ T _____ R _____	_____
	S _____ T _____ R _____	_____
3. Miscellaneous Property in Sec.	S _____ T _____ R _____	_____
	S _____ T _____ R _____	_____
4. Lot No. _____, Recorded Plat _____		
5. Private Claims _____		

Compliance with  
ACT 345, P.A. 1990

APPROVED ON: 12-7-99 [Signature]

WAYNE COUNTY REMONUMENTATION  
PEER GROUP COMMITTEE

Register of Deeds Stamp & File Number

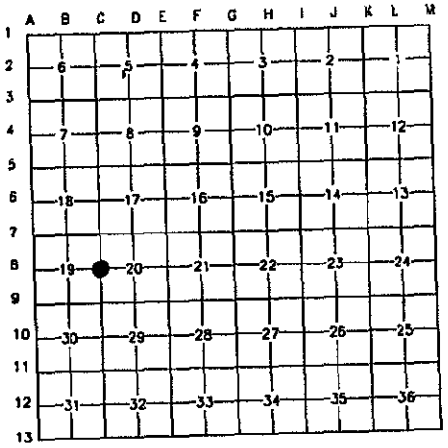

I, CHRISTOPHER S. LAMUS, in a field survey on MARCH 2, 19 99, do hereby certify that under requirements of P.A. 74, Michigan P.A. of 1970, the corner points mentioned in lines 1 and 2 above were in conformance with regulations and rules therefore as required in the current manual of survey instructions of the United States Department of the Interior, Bureau of Land Management or by decree of a Court of Law and/or that the corner points mentioned in lines 3, 4 and 5 above were in conformance with the rules of the Michigan Board of Land Surveyors or by Decree of a Court of Law; established, re-established, monumented, re-monumented, recovered, found as expressed below:

NOTE: Not more than 4 corners, all in the same town and range, may be recorded on this certificate

A. Description of original monument and accessories and/or subsequent restoration:  
 ORIG. GOVERNMENT NOTES 1817  
 WITNESSED BY FLETCHER - SET POST  
 S 19° E 6 LINKS 6' B.O. (1)  
 S 60° W 44 LINKS 6' B.O. (2)  
 NO G.L.O. WITNESSES REMAIN

B. Description of corner evidence and/or method applied in restoring or reestablishing corner:

WAYNE CO. BUREAU OF TAXATION (1930'S)  
 MONUMENT (NO DESCRIPTION)  
 N.W. 50.47' ED. POLE (3) FOUND  
 S.W. 49.58' C.B. (4) GONE  
 S.E. 42.85' W.C.R. (5) GONE  
 S.E. 46.70' ED. POLE (6) GONE  
 ELY 7.81' IRON (7) FOUND  
 N.E. 73.40' W.C.R. (8) GONE  
 N.E. 71.59' ED. POLE (9) FOUND

PUBLIC ACT 74 L.C.R.C. L.22105 P.597 (1984)  
 (C-8) FOUND 3/4" ROD IN MON. BOX @ OZGA ROAD AND HURON RIVER DRIVE.  
 N 30° W 50.47' P.P. (3) FOUND  
 EAST 7.81' MON. BOX (14) FOUND  
 N 75° E 67.54' CHIS "X" ON M.H. RIM (13) GONE  
 S 35° E 56.31' CHIS "X" ON CONC. SIGN BASE (12) GONE


WAYNE CO. ROAD COMMISSION 1973  
 MONUMENT (NO DESCRIPTION)  
 N.W. 77.89' S.E. COR. BOTTOM CONC. STEPS (10) FOUND  
 N.W. 50.47' POLE (3) FOUND  
 S.W. 73.22' "X" CUT IN M.H. RIM (11) GONE  
 S.E. 56.31' "X" CUT IN SIGN BASE (12) GONE  
 N.E. 67.54' "X" CUT IN RIM OF M.H. (13) GONE

PUBLIC ACT 74 L.C.R.C. L.26540 P.367 (1993)  
 (C-8) FOUND 1/4" IRON IN MON. BOX @ CENTERLINE OF OZGA & HURON RIVER DRIVE.  
 EAST 7.81' MON. BOX @ CENTERLINE OF GODDARD & GRANT RDS. (14) FOUND  
 N 71° E 51.07' WITNESS TAG IN S. SIDE OF D.E. POLE (15) GONE  
 S 39° E 46.63' WITNESS TAG IN D.E. POLE (6) GONE  
 S 23° W 114.50' WITNESS TAG IN E. SIDE D.E. POLE (16) GONE  
 N 35° W 50.47' WITNESS TAG E. SIDE D.E. POLE (3) FOUND

DISTANCE TO C-9 2658.89' (M) RECORDED AS 2658.93' BY WAYNE COUNTY BUREAU OF TAXATION.  
 DISTANCE TO D-8 2673.85' (M) RECORDED AS 2673.00' BY WAYNE COUNTY BUREAU OF TAXATION.

C. Description of monument for corner and accessories established to perpetuate locating the position

C-8  
 3/4" RE-BAR IN MON. BOX  
 SET BRASS W.C. WASHER AND SURVEYOR'S CAP #41914 OVER 3/4" RE-BAR IN MON BOX.  
 CORNER IS LOCATED IN PAVEMENT OF OZGA ROAD AND HURON RIVER DRIVE.  
 N 64° E 71.61' SET W.C. RE-MON BRASS WASHER IN N.W. SIDE POWER POLE. (9)  
 EAST 7.81' FOUND 3/4" RE-BAR IN MON. BOX. (14)  
 S 46° E 46.91' SET W.C. RE-MON BRASS WASHER IN N.E. SIDE POWER POLE. (6)  
 S 15° W 117.91' SET W.C. RE-MON BRASS WASHER IN N.W. SIDE POWER POLE. (17)  
 N 39° W 50.51' SET W.C. RE-MON BRASS WASHER IN S.W. SIDE POWER POLE. (3)

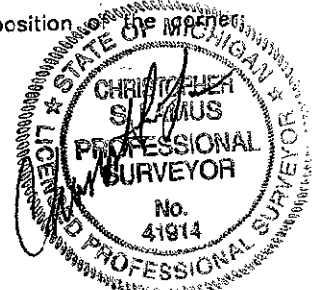

THE SELECTED LOCATION IS ACCEPTED BY THE CONTRACTOR AND IS GENERALLY ACCEPTED BY PROFESSIONAL SURVEYORS AS THE BEST AVAILABLE EVIDENCE OF THE POSITION OF THE ORIGINAL CORNER.

Signed by [Signature]  
 Surveyor's Michigan License No. 41914

Date 12/23/99

R LCR 9 4R 1Pg A DPJ