

FEB 28 1994

RC 1339

COMMISSION

LAND CORNER RECORDATION CERTIFICATE  
Filing Requirement of Act 74, Mich. P.A. 1970

For corners in

WAYNE  
County:

ROMULUS TOWNSHIP #13 Located in: Corner Code #

1. Public Land Survey		T 3 S	R 9 E	C-11
		T	R	
		T	R	
		T	R	
2. Property Controlling in Section	S	T	R	
	S	T	R	
3. Miscellaneous Property in Sec.	S	T	R	
	S	T	R	

4. Lot No. \_\_\_\_\_, Recorded Plat \_\_\_\_\_

5. Private Claims \_\_\_\_\_

LI27042PA361

Compliance with  
ACT 345, P.A. 1990  
APPROVED ON: 12-15-93  
WAYNE COUNTY REMONUMENTATION  
PEER GROUP COMMITTEE

Register of Deeds Stamp & File Number

RC 1339

I, Kenneth S. Wilkerson, in a field survey on October 28, 19 93, do hereby certify that under requirements of P.A. 74, Michigan P.A. of 1970, the corner points mentioned in lines 1 and 2 above were in conformance with regulations and rules therefore as required in the current manual of survey instructions of the United States Department of the Interior, Bureau of Land Management or by a decree of a Court of Law and/or that the corner points mentioned in lines 3, 4 and 5 above were in conformance with the rules of the Michigan Board of Land Surveyors or by a Decree of a Court of Law; established, re-established, monumented, re-monumented, recovered, found as expressed below:

NOTE: Not more than 4 corners, all in the same town and range, may be recorded on this certificate.

A. Description of original monument and accessories and/or subsequent restoration:

C-11 Set Post - GLO - NO GLO WITNESSES REMAIN  
Fd. Iron - B of T  
Fd. Iron - L. 19194, P. 811 - 08/28/75

NE 78.90 nail in SE face 5" maple  
SE 58.85 WCRC sign post  
SW 82.10 nail in SW face 12" elm  
W 25.80 mon.  
NW 44.75 nail in SW face PP

B. Description of corner evidence found and/or method applied in restoring or reestablishing corner:

C-11 Fd. mon. in mon. box  
SE 61.23 WCRC tag NE face PP  
S 30 W 58.60 PK in NW face PP  
N 45 W 44.83 nail in NE face GP

C. Description of monument for corner and accessories established to perpetuate locating the position of the corner:


Set WC remonumentation washer and OHM KSW 21584 cap on iron.

C-11 N 28 E 90.78 OHM tag in SE face UP  
S 30 E 61.47 OHM tag in SW face PP  
S 35 W 58.34 OHM tag in E face PP  
N 50 W 44.83 WCRC tag in NE face PP

The selected location is accepted as the best evidence of the original corner.

A	B	C	D	E	F	G	H	I	J	K	L	M
2	6	5	4	3	2	1						
3												
4	7	8	9	10	11	12						
5												
6	18	17	16	15	14	13						
7												
8	19	20	21	22	23	24						
9												
10	30	29	28	27	26	25						
11												
12	31	32	33	34	35	36						
13												

5:00:15 PM 5-00  
FOREST & COUNSEL  
REGISTERED DEEDS  
MICHIGAN STATE BOARD OF LAND SURVEYORS

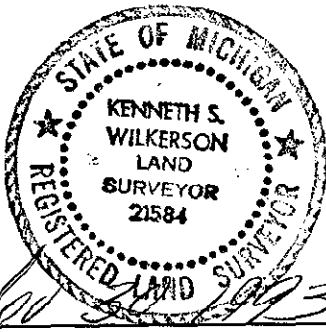

Signed by: [Signature]

Date: Nov 2 1993

Drafted By: Kenneth S. Wilkerson  
Surveyor's Michigan License No. 21584

Orchard, Hiltz & McCliment, Inc.  
34935 Schoolcraft Road \* Livonia, Michigan 48150 \* Phone: (313) 522-6711

FORM APPROVED BY MICHIGAN STATE BOARD OF LAND SURVEYORS, JAN. 26, 1971  
REVISED MAY 14, 1975  
REVISED JAN., 1983

26