

**SURVEY &
REMONUMENTATION**

RC 1620

APR 25 1995

LAND CORNER RECORDATION CERTIFICATE

LI27802PA183

Filing Requirement of Act 74, Mich. P.A. 1970

C-12 Page 1

COMMISSION

For corners in

Wayne

Located in: Romulus Corner Code

County
ROMULUS

1. Public Land Survey

T 3 S R 9 E C-12

T _____ R _____

T _____ R _____

T _____ R _____

2. Property Controlling
in Section

S _____ T _____ R _____

S _____ T _____ R _____

3. Miscellaneous
Property in Sec.

S _____ T _____ R _____

S _____ T _____ R _____

4. Lot No. _____, Recorded Plat _____

5. Private Claims _____

Compliance with
ACT 345, P.A. 1990

APPROVED ON: 12-9-94
WAYNE COUNTY REMONUMENTATION
PEER GROUP COMMITTEE

Register of Deeds Stamp and File Number

I, Kenneth S. Wilkerson in a field survey on 11/30/1994
do hereby certify that under requirements of P.A. 74, Michigan P.A. of 1970, the corner points mentioned in lines 1 and 2 above were in conformance with regulations and rules therefore as required in the current manual of survey instructions of the United States Department of the Interior, Bureau of Land Management, or by a decree of a Court of Law and/or that the corner points mentioned in lines 3, 4 and 5 above were in conformance with the rules of the Michigan Board of Land Surveyors or by a Decree of a Court of Law, established, re-established, monumented, re-monumented, recovered, found as expressed below.

NOTE: Not more than 4 corners, all in the same town and range, may be recorded on this certificate.

	A	B	C	D	E	F	G	H	I	J	K	L	M
2	6	5	4	3	2	1							
3													
4	7	8	9	10	11	12							
5													
6	18	17	16	15	14	13							
7													
8	19	20	21	22	23	24							
9													
10	30	29	28	27	26	25							
11													
12	31	32	33	34	35	36							
13													

A. Description of original monument and accessories and/or subsequent restorations:

01/01/1816 G.L.O. Set post.
NO WITNESSES REMAIN
01/01/1930 B of T Fd. iron
4 SE 111.00 NAIL IN SW FACE MBT P

(Witnesses Continued on Back ...)

B. Description of corner evidence found and/or method applied in restoring or reestablishing corner:

Fd. mon. in mon. box

C. Description of monument for corner and accessories established to perpetuate localing the position of the miscellaneous recording

11/30/1994 Wilkerson 21584 O.I.M. Remon.

SET W.C.R. WASHER AND CAP ON CORNER
4 S 15 E 111.93 WCRC TAG IN W FACE MBT P
10 N 70 E 31.58 OHM TAG IN S FACE MBT P
11 S 35 W 97.00 OHM TAG IN SE FACE 14" SYCAMORE
12 S 75 W 56.87 OHM TAG IN N FACE 12" MAPLE


28 DEC 94 1:36 P.M. RECEIPT# 518
RECORDED
FOREST E. YOUNGBLOOD, REGISTER OF DEEDS
WAYNE COUNTY, MI

We conclude that after careful study of the record documentation and field observations, that this corner is accepted as the best available evidence of the position of the original corner.

Signed by [Signature]
Drafted by Kenneth S. Wilkerson
Surveyor's Michigan License No. 21584

Date 12-9-94

Orchard, Hiltz and McCliment, Inc. 34935 Schoolcraft Road Livonia, MI 48150

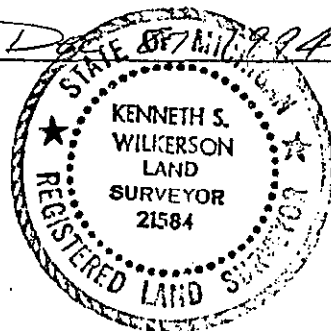

2R
140
MISC

RC 1620

A. (Continued) Description of original monument and accessories and/or subsequent restorations:

01/01/1930

B of T Fd. iron

- 1 NE 72.20 NAIL IN W FACE 24" WALNUT
- 2 NE 39.08 NAIL IN NW FACE 26" WALNUT
- 3 E 36.60 IRON

10/25/1989

L24417, P157 Fd. iron

- 5 NE 78.90 NAIL IN SE FACE 5" MAPLE
- 6 SE 58.85 WCRC SIGN POST
- 7 SW 82.10 NAIL IN SW FACE 12" ELM
- 8 W 25.80 MON.
- 9 NW 44.75 NAIL IN SW FACE P.P.