

**SURVEY &  
REMONUMENTATION**

**RC 1446**

**LAND CORNER RECORDATION CERTIFICATE**

**L127794PA318**

**APR 25 1995**

**Filing Requirement of Act 74, Mich. P.A. 1970**

C-13 Page 1

**COMMISSION**

For corners in

Wayne

Located in: Romulus Corner Code

County

1. Public Land Survey

T 3 S R 9 E

C-13 ✓

T \_\_\_\_\_ R \_\_\_\_\_

T \_\_\_\_\_ R \_\_\_\_\_

T 45 R 9E

C-1

2. Property Controlling  
in Section

S \_\_\_\_\_ T \_\_\_\_\_ R \_\_\_\_\_

S \_\_\_\_\_ T \_\_\_\_\_ R \_\_\_\_\_

3. Miscellaneous  
Property in Sec.

S \_\_\_\_\_ T \_\_\_\_\_ R \_\_\_\_\_

S \_\_\_\_\_ T \_\_\_\_\_ R \_\_\_\_\_

4. Lot No. \_\_\_\_\_, Recorded Plat \_\_\_\_\_

5. Private Claims \_\_\_\_\_

Compliance with  
ACT 345, P.A. 1990

APPROVED ON: 12/9/94 MCD  
WAYNE COUNTY REMONUMENTATION  
PEER GROUP COMMITTEE

Register of Deeds Stamp and File Number

I, Kenneth S. Wilkerson in a field survey on 11/07/1994  
do hereby certify that under requirements of P.A. 74, Michigan P.A. of 1970, the corner points mentioned in lines 1 and 2 above were in conformance with regulations and rules therefore as required in the current manual of survey Instructions of the United States Department of the Interior, Bureau of Land Management, or by a decree of a Court of Law and/or that the corner points mentioned in lines 3, 4 and 5 above were in conformance with the rules of the Michigan Board of Land Surveyors or by a Decree of a Court of Law, established, re-established, monumented, re-monumented, recovered, found as expressed below.

NOTE: Not more than 4 corners, all in the same town and range, may be recorded on this certificate.

	A	B	C	D	E	F	G	H	I	J	K	L	M
2	6	5	4	3	2	1							
3													
4	7	8	9	10	11	12							
5													
6	18	17	16	15	14	13							
7													
8	19	20	21	22	23	24							
9													
10	30	29	28	27	26	25							
11													
12	31	32	33	34	35	36							
13													

A. Description of original monument and accessories and/or subsequent restorations:

01/01/1816

G.L.O.

Set post

10" B. ASH N 23 W 27 (17.82') (GONE)  
CORNER COMMON TO C-1 HURON TWP.

(Witnesses Continued on Back ...)

B. Description of corner evidence found and/or method applied in restoring or reestablishing corner:

Fd. 3/4" iron pipe in mon. box w/cover in asph. pav't. @ int. cl's of Pennsylvania & Huron River Dr. Dist. to D-13 = 2655.27' (R), 2655.82' (M) & Dist. to C-12 = 2619.90' (R), 2622.57' (M)

C. Description of monument for corner and accessories established to perpetuate locating the position of the corner:

11/07/1994 Wilkerson 21584 O.H.M. Remon

COMMON CORNER WITH C-1, HURON TWP.  
SET 1/2" I.R. IN 3/4" I.P. W/W.C.R. WASHER & TAG ON CORNER.


- 6 TOP BOLT ON HYDRANT N 30 E 65.72'
- 7 W.C.R. TAG N./S P.P. S 50 E 44.02'
- 9 W.C.R. TAG E./S P.P. N 40 W 42.50'
- 12 W.C.R. TAG S./S P.P. N 50 E 72.85'
- 13 W.C.R. TAG N./S P.P. S 45 W 100.30'
- 15 DIST. TO C-02 T.4S., R.9E. = 2620.16'
- 17 ANGLE B.S. D-13, F.S. C-12 = 90°09'52"

\$ 16.00 MISCELLANEOUS RECORDING  
21 DEC 94 3:31 P.M. RECEIPT# 930  
REGISTER OF DEEDS

We conclude that after careful study of the record documentation and field observations, that this corner is accepted as the best available evidence of the position of the original corner.

Signed by [Signature]  
Drafted by Kenneth S. Wilkerson  
Surveyor's Michigan License No. 21584

Date Dec 21 1994

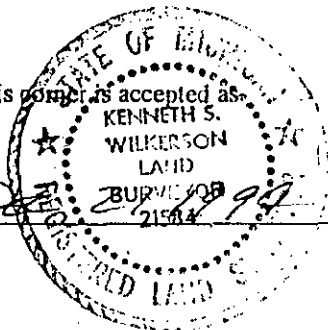

Orchard, Hiltz and McCliment, Inc. 34935 Schoolcraft Road Livonia, MI 48150

2 R  
14-N-1M1

## A (Continued) Description of original monument and accessories and/or subsequent restorations:

01/01/1816		G.L.O.	Set post	L127794PA319
	10" W.O. N 74 E 81 LINKS (53.46') (GONE)			
01/01/1930		B/T	Fd. iron	
	1 15" WALNUT N. E. 91.43' (GONE)			
	2 30" OAK S. E. 58.25' (GONE)			
	3 8" WALNUT S. W. 93.03' (GONE)			
	4 20" MAPLE N. E. 39.85' (GONE)			
	5 CROSS IN W.C.R. SIGN POST N. E. 41.65' (GONE)			
	14 DIST. TO C-12 = 2619.90'			
	15 DIST. TO C-02 T.4S., R.9E. = 2619.59'			
	16 DIST. TO D-13 = 2655.27'			
	17 ANGLE TO R. B.S. C-12, F.S. D-13 = 90-13'30"			
03/01/1967	Stubits	M.D.O.T.		1" X 1" bolt flush with bit.
	6 FIRE HY. N 30 E 65.72'			
	7 M.B.T. POLES 25 E 44.01'			
	8 7" WALNUT S 85 W 94.06' (GONE)			
	9 P.P. N 40 W 42.84'			
	16 DIST. TO D-13 = 2655.27'			
	17 ANGLE TO R. B.S. C-12, F.S. D-13 = 90°20'00"			
04/23/1970		W.C.R.C.		Fd. iron
	7 M.B.T. S. E. 44.02'			
	9 D.E. GUY POLE N. W. 42.68'			
	10 10" WALNUT N. W. 84.29' (GONE)			
	11 18" WALNUT N. E. 111.61' (GONE)			
11/07/1994	Wilkerson	21584	O.H.M.	Fd. 3/4" iron pipe
	10 FD. DEAD REMAINS OF WALNUT N 15 W 84'			
	11 FD. DYING REMAINS OF WALNUT N 80 E 112'			