

APR 05 1996

LAND CORNER RECORDATION CERTIFICATE

Filing Requirement of Act 74, Mich. P.A. 1970

E-05 Page 1

COMMISSION

For corners in

Wayne

Located in: Romulus Corner Code

County

- |                                       |   |   |   |   |   |   |      |
|---------------------------------------|---|---|---|---|---|---|------|
| 1. Public Land Survey                 | T | 3 | S | R | 9 | E | E-05 |
|                                       | T |   |   | R |   |   |      |
|                                       | T |   |   | R |   |   |      |
|                                       | T |   |   | R |   |   |      |
| 2. Property Controlling in Section    | S |   |   | T |   |   |      |
|                                       | S |   |   | T |   |   |      |
| 3. Miscellaneous Property in Sec.     | S |   |   | T |   |   |      |
|                                       | S |   |   | T |   |   |      |
| 4. Lot No. _____, Recorded Plat _____ |   |   |   |   |   |   |      |
| 5. Private Claims _____               |   |   |   |   |   |   |      |

LIBER 28647 PAGE 721

Compliance with  
ACT 345, P.A. 1990

APPROVED ON: 11-30-95  
WAYNE COUNTY REMONUMENTATION  
PEER GROUP COMMITTEE

Register of Deeds Stamp and File Number

I, Kenneth S. Wilkerson in a field survey on 11/10/1995 do hereby certify that under requirements of P.A. 74, Michigan P.A. of 1970, the corner points mentioned in lines 1 and 2 above were in conformance with regulations and rules therefore as required in the current manual of survey instructions of the United States Department of the Interior, Bureau of Land Management, or by a decree of a Court of Law and/or that the corner points mentioned in lines 3, 4 and 5 above were in conformance with the rules of the Michigan Board of Land Surveyors or by a Decree of a Court of Law, established, re-established, monumented, re-monumented, recovered, found as expressed below.

NOTE: Not more than 4 corners, all in the same town and range, may be recorded on this certificate.

	A	B	C	D	E	F	G	H	I	J	K	L	M
2	6	5	4	3	2	1							
3													
4	7	8	9	10	11	12							
5													
6	18	17	16	15	14	13							
7													
8	19	20	21	22	23	24							
9													
10	30	29	28	27	26	25							
11													
12	31	32	33	34	35	36							
13													

A. Description of original monument and accessories and/or subsequent restorations:

01/01/1816

G.L.O. Set post

12" B.O. S 29 W 1.64 LINKS (1.08') (GONE)  
12" W.O. S 31 E 21 LINKS (13.86') (GONE)

(Witnesses Continued on Back ...)


B. Description of corner evidence found and/or method applied in restoring or reestablishing corner:

1" IRON BAR DIST. TO F-5=2636.41'(R) 2636.91'(M) DIST TO E-6=2646.72'(R) 2647.10'(M)  
IN MON BOX ASPHALT PAVEMENT

C. Description of monument for corner and accessories established to perpetuate locating the position of the corner:

11/10/1995 Wilkerson 21584 O.H.M. Remon

- SET W.C.R. CAP OVER FD 1" I. BAR
- 5 W.C.R. TAG N.E./S P.P. S 48 E 60.42'
- 6 W.C.R. TAG N./S P.P. 142.01'
- 12 N.W. FENCE POST N 33 E 62.22'
- 13 W.C.R. TAG S.W./S P.P. N 47 W 47.29'

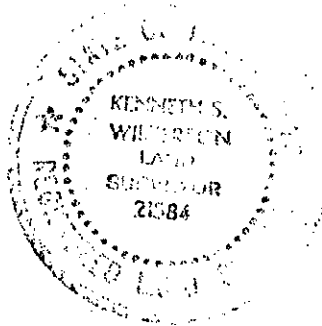

95273122  
96065630

96 MAR -7 AM 11-27  
FOREST E. YOUNGBLOOD  
REGISTER OF DEEDS  
WAYNE COUNTY, MI

We conclude that after careful study of the record documentation and field observations, that this corner is accepted as the best available evidence of the position of the original corner.

Signed by [Signature]  
Drafted by Kenneth S. Wilkerson  
Surveyor's Michigan License No. 21584

Date DEC 8 1995

Orchard, Hiltz and McCliment, Inc. 34935 Schoolcraft Road Livonia, MI 48150

RECORDED TO ADD PEER GROUP DATE

\$ 10.00 DEED  
21 DEC 95 9:20 A.M. RECEIPT# 58  
RECORDED  
FOREST E. YOUNGBLOOD, REGISTER OF DEEDS  
WAYNE COUNTY, MI  
\$ 4.00 REMONUMENTATION

nlc  
ak  
10/20/95  
K.S.

A. (Continued) Description of original monument and accessories and/or subsequent restorations:

LIBER 28477 PAGE 213

LIBER 28647 PAGE 722

01/01/1930

B/T Fd. iron

- 1 W.C.R. SIGN POST N. E. 40.13'
- 2 D.E. POLE S. E. 46.78'
- 3 D.E. POLE S. W. 61.95'
- 4 TEL POLE NW 44.18'

04/01/1970

Qwiggins M.D.O.T.

Fd. conc. mon. in mon. box

- 2 P.P. S 40 E 46.96'
- 5 P.P. N 45 W 60.39'
- 13 CH. LINK F.P. N 50 E 47.55'
- 14 N.E. COR. OF C.B. N 35 E 45.95'

04/29/1970

W.C.R.C.

Fd. mon. in box

- 2 D.E. POLE N. W. 46.95'
- 5 TRAFFIC SIGNAL GUY S. E. 60.38'
- 6 M.B.T. S. E. 142.30'

10/23/1979

W.C.R.C.

B/T Fd. mon. in box.

- 2 D.E. POLE SPIKE W/TAG N. W. 46.87'
- 5 TRAFFIC SIGNAL GUY W/TAG S. E. 60.50'
- 7 "X" IN KEY FLAG S. W. 79.73'
- 8 P.K. NAIL ON SECTION LINE SOUTH 46.85'
- 9 P.K. NAIL ON SECTION LINE NORTH 53.15'

07/10/1987

Sandomierski 24616

R. C.

Fd. 1/2" iron in mon. box

- 2 NAIL SW SIDE UP N 48-23 W 46.78'
- 5 N.E. SIDE GUY POLE W/TAG S 48-55 E. 60.59'
- 10 P.K. NAIL W SIDE 8" ELM N 30-11 E 64.96'
- 11 N W STREET SIGN POST S 44-08 W 62.25'