

FEB 26 1994

LAND CORNER RECORDATION CERTIFICATE  
Filing Requirement of Act 74, Mich. P.A. 1970

COMMISSION

For corners in

LI27042PA363

WAYNE  
County:  
ROMULUS TOWNSHIP #13

Located in: Corner Code #

1. Public Land Survey	T 3 S	R 9 E	E-07
	T	R	
	T	R	
	T	R	
2. Property Controlling in Section	S	T	R
	S	T	R
3. Miscellaneous Property in Sec.	S	T	R
	S	T	R

4. Lot No. \_\_\_\_\_, Recorded Plat \_\_\_\_\_

5. Private Claims \_\_\_\_\_

Compliance with  
ACT 345, P.A. 1990

APPROVED ON: 12-15-93  
WAYNE COUNTY REMONUMENTATION  
PEER GROUP COMMITTEE

Register of Deeds Stamp & File Number

RC 1341

I, Kenneth S. Wilkerson, in a field survey on September 30, 19 93  
do hereby certify that under requirements of P.A. 74, Michigan P.A. of 1970, the corner points mentioned in lines 1 and 2 above were in conformance with regulations and rules therefore as required in the current manual of survey instructions of the United States Department of the Interior, Bureau of Land Management or by a decree of a Court of Law and/or that the corner points mentioned in lines 3, 4 and 5 above were in conformance with the rules of the Michigan Board of Land Surveyors or by a Decree of a Court of Law; established, re-established, monumented, re-monumented, recovered, found as expressed below:

NOTE: Not more than 4 corners, all in the same town and range, may be recorded on this certificate.

A. Description of original monument and accessories and/or subsequent restoration:

E-07 Set Post - GLO - NO GLO WITNESSES REMAIN  
Fd. Iron - B of T  
Mon. in box - WCRC 04/04/70  
Mon. in mon. box - MDOT, L. 21145, P. 441

B. Description of corner evidence found and/or method applied in restoring or reestablishing corner:

E-07 Fd. conc. mon. in mon. box  
NE 71.44 WCRC tag in SE face PP  
SW 81.20 WCRC tag in NW face PP - Fd.  
NW 62.58 WCRC tag in NE face PP Fd. - Fd.  
SE 72.47 MDOT tag in NE face PP - Fd.

C. Description of monument for corner and accessories established to perpetuate locating the position of the corner:

Set WC remonumentation washer and OHM KSW 21584 cap on iron.

E-07 052 AZ 74.45 OHM tag SE face PP  
142 AZ 72.50 MDOT tag N face PP  
225 AZ 81.35 OHM tag N Face PP  
315 AZ 62.55 OHM tag E face PP

The selected location is accepted as the best evidence of the original corner.

Signed by: [Signature]

Date: Nov 30 1993


Drafted By: Kenneth S. Wilkerson  
Surveyor's Michigan License No. 21584

Orchard, Hiltz & McCliment, Inc.  
34935 Schoolcraft Road \* Livonia, Michigan 48150 \* Phone: (313) 522-6711

FORM APPROVED BY MICHIGAN STATE BOARD OF LAND SURVEYORS, JAN. 28, 1971  
REVISED MAY 14, 1975  
REVISED JAN., 1983

A	B	C	D	E	F	G	H	I	J	K	L	M
2	6	5	4	3	2	1						
3												
4	7	8	9	10	11	12						
5												
6	18	17	16	15	14	13						
7												
8	19	20	21	22	23	24						
9												
10	30	29	28	27	26	25						
11												
12	31	32	33	34	35	36						
13												

93 DEC 15 PM 5:00  
FOREST E. JOHNSON  
REGISTERED DEEDS  
MICHIGAN STATE BOARD OF LAND SURVEYORS

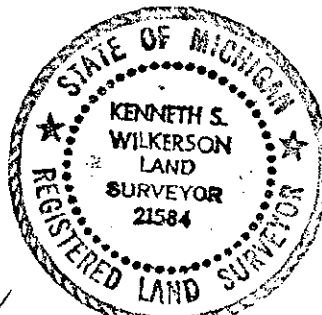

[Handwritten initials]