

SURVEY & REMONUMENTATION

RC 1621

LI27802PA185

LAND CORNER RECORDATION CERTIFICATE

LI27802PA185

Filing Requirement of Act 74, Mich. P.A. 1970

APR 25 1995

COMMISSION

Wayne

Located in: ROMULUS Corner Code

County

- 1. Public Land Survey T 3 S R 9 E G-02
- T _____ R _____
- T _____ R _____
- T _____ R _____
- 2. Property Controlling S _____ T _____ R _____
- In Section S _____ T _____ R _____
- 3. Miscellaneous S _____ T _____ R _____
- Property In Sec. S _____ T _____ R _____
- 4. Lot No. _____, Recorded Plat _____
- 5. Private Claims _____

Compliance with ACT 345, P.A. 1990

APPROVED ON: 12-9-94 [Signature] WAYNE COUNTY REMONUMENTATION PEER GROUP COMMITTEE

Register of Deeds Stamp and File Number

I, Kenneth S. Wilkerson in a field survey on 11/30/1993 do hereby certify that under requirements of P.A. 74, Michigan P.A. of 1970, the corner points mentioned in lines 1 and 2 above were in conformance with regulations and rules therefore as required in the current manual of survey instructions of the United States Department of the Interior, Bureau of Land Management, or by a decree of a Court of Law and/or that the corner points mentioned in lines 3, 4 and 5 above were in conformance with the rules of the Michigan Board of Land Surveyors or by a Decree of a Court of Law, established, re-established, monumented, re-monumented, recovered, found as expressed below.

NOTE: Not more than 4 corners, all in the same town and range, may be recorded on this certificate.

A	B	C	D	E	F	G	H	I	J	K	L
2	6	5	4	3	2	1					
3											
4	7	8	9	10	11	12					
5											
6	18	17	16	15	14	13					
7											
8	19	20	21	22	23	24					
9											
10	30	29	28	27	26	25					
11											
12	31	32	33	34	35	36					
13											

A. Description of original monument and accessories and/or subsequent restorations:

01/01/1819 G.L.O. SET POST
NO WITNESSES REMAIN TODAY

(Witnesses Continued on Back ...)

B. Description of corner evidence found and/or method applied in restoring or reestablishing corner:

FD. MON. IN MON. BOX

C. Description of monument for corner and accessories established to perpetuate locating the position of the corner:

11/30/1993 WILKERSON 21584 O.H.M. REMON
SET W.C.R. WASHER AND CAP ON CORNER.
12 O.H.M. TAG S FACE MBT POLE N70E 31.58'
13 W.C.R.C. TAG IN W. FACE MBT POLE S 15 E 111.93'
14 O.H.M. TAG SE FACE 14" SYCAMORE S35W 97.00'
15 O.H.M. TAG N FACE 12" MAPLE S75W 56.87'


\$ 16.00 MISCELLANEOUS RECORDING
28 DEC 94 1:36 P.M. RECEIPT# 51B
RECORDED
FOREST E. YOUNGBLOOD, REGISTER OF DEEDS
WAYNE COUNTY, MI

We conclude that after careful study of the record documentation and field observations, that this corner is accepted as the best available evidence of the position of the original corner.

Signed by [Signature]
Drafted by Kenneth S. Wilkerson
Surveyor's Michigan License No. 21584

Date DEC 27, 1994

Orchard, Hiltz and McCliment, Inc. 34935 Schoolcraft Road Livonia, MI 48150

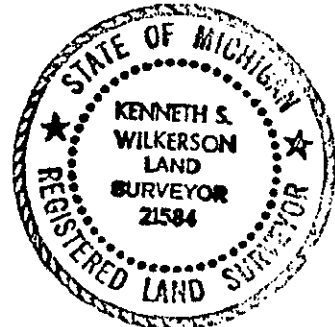

2R
14 D
MISC.

(Continued) Description of original monument and accessories and/or subsequent restorations:

01/01/1930	W.C.B.T.	FD. STONE	LI27802PA186
1	18" ELM NW 82.64'		
2	30" MAPLE SE 72.46'		
3	30" MAPLE SW 20.66'		
4	20" MAPLE SW 81.58'		
02/06/1973	ARTHURS 11358	FD. STONE	
5	F.P. S1-40'E 34.66'		
6	SPIKE IN U.P. N62W 35.12'		
7	IRON PIPE STAKE N34E 40.04'		
10/07/1982	ANDRES 18981	FD. STONE	
8	P.K. NAIL S/S OF 5" ELM S41E 45.59'		
9	TOP BOLT OF HYD. S69E 84.24'		
10	S71W 85.45' G,V,&W MII RIM		
11	P.K. NAIL IN S/S 8" ELM N43W 31.67'		