

APR 05 1996

LAND CORNER RECORDATION CERTIFICATE

Filing Requirement of Act 74, Mich. P.A. 1970

G-04 Page 1

COMMISSION

For corners in

Wayne

Located in: Romulus Corner Code

County

LIBER 28647 PAGE 723

- | | | | | | | | |
|------------------------------------|---|---|---|---|---|---|------|
| 1. Public Land Survey | T | 3 | S | R | 9 | E | G-04 |
| | T | | | R | | | |
| | T | | | R | | | |
| | T | | | R | | | |
| 2. Property Controlling In Section | S | | | T | | | |
| | S | | | T | | | |
| 3. Miscellaneous Property in Sec. | S | | | T | | | |
| | S | | | T | | | |
4. Lot No. _____, Recorded Plat _____
5. Private Claims _____

Compliance with
ACT 345, P.A. 1990

APPROVED ON: 11-30-95
WAYNE COUNTY REMONUMENTATION
PEER GROUP COMMITTEE

Register of Deeds Stamp and File Number

I, Kenneth S. Wilkerson in a field survey on 11/04/1995
do hereby certify that under requirements of P.A. 74, Michigan P.A. of 1970, the corner points mentioned in lines 1 and 2 above were in conformance with regulations and rules therefore as required in the current manual of survey instructions of the United States Department of the Interior, Bureau of Land Management, or by a decree of a Court of Law and/or that the corner points mentioned in lines 3, 4 and 5 above were in conformance with the rules of the Michigan Board of Land Surveyors or by a Decree of a Court of Law, established, re-established, monumented, re-monumented, recovered, found as expressed below.

NOTE: Not more than 4 corners, all in the same town and range, may be recorded on this certificate.

	A	B	C	D	E	F	G	H	I	J	K	L	M
2	6	5	4	3	2	1							
3													
4	7	8	9	10	11	12							
5													
6	18	17	16	15	14	13							
7													
8	19	20	21	22	23	24							
9													
10	30	29	28	27	26	25							
11													
12	31	32	33	34	35	36							
13													

A. Description of original monument and accessories and/or subsequent restorations:

01/01/1816

G.L.O.

Set post

- 9" B. ASH N 43 W 7 LINKS (4.62') (GONE)
- 9" B. ASH S 42 E 12 LINKS (7.92') (GONE)

96065631
95273121

(Witnesses Continued on Back ...)


B. Description of corner evidence found and/or method applied in restoring or reestablishing corner:

3/4" IRON IN MON. BOX DIST TO G-3 2629.54'(R) 2629.44'(M) DIST. TO G-5 2615.36'(R) 2615.51'(M)

C. Description of monument for corner and accessories established to perpetuate locating the position of the corner:

11/04/1995 Wilkerson 21584 O.H.M. Remon

- SET W.C.R. WASHER AND CAP OVER FD. 3/4" IRON.
- 5 CL M.B.T. M.H. N22W 29.75'
- 6 CL TOP HYD. N64E 148.84'
- 7 O.H.M. TAG IN P.P. N69E 7.56'
- 8 CL TOP HYD S24E 156.03'

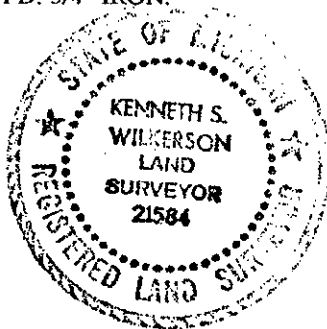

96 MAR -7 AM 11:27

We conclude that after careful study of the record documentation and field observations, that this corner is accepted as the best available evidence of the position of the original corner.

Signed by: [Signature]
Drafted by: Kenneth S. Wilkerson

Date: DEC 8 1995

Surveyor's Michigan License No. 21584

Orchard, Hiltz and McCliment, Inc. 34935 Schoolcraft Road Livonia, MI 48150

\$ 10.00 DEED
21 DEC 95 9:20 A.M. RECEIPT# 58
RECORDED
FOREST E. YOUNGBLOOD, REGISTER OF DEEDS
WAYNE COUNTY, MI

\$ 4.00 REMONUMENTATION

RERECORD TO ADD PEER GROUP DATE

RECORDED
WILKORD
WIC
PCH
10/25
12/25

A. (Continued) Description of original monument and accessories and/or subsequent restorations:

LIBER 28477 PAGE 211

01/01/1930

Wayne Co.

B/T

Fd. iron

- 1 4" TRIPLE ELM SE 13.85'
- 2 16" OAK SW 94.70
- 3 28" OAK SW 191.25'
- 4 TWIN 12" ELM NW 126.31'

LIBER 28647 PAGE 724

FILED DO NOT MAIL

RECORDED