

FEB 28 1994

COMMISSION

# RC 1344

LAND CORNER RECORDATION CERTIFICATE  
Filling Requirement of Act 74, Mich. P.A. 1970

LI27042PA366

For corners in

WAYNE

County:

ROMULUS TOWNSHIP #13

Located in:

Corner Code #

1. Public Land Survey		T <u>3 S</u>	R <u>9 E</u>	<u>G-07</u>
		T _____	R _____	_____
		T _____	R _____	_____
		T _____	R _____	_____
2. Property Controlling in Section	S _____	T _____	R _____	_____
	S _____	T _____	R _____	_____
3. Miscellaneous Property in Sec.	S _____	T _____	R _____	_____
	S _____	T _____	R _____	_____

Compliance with  
ACT 345, P.A. 1990

APPROVED ON: 12-15-93 *POJ*  
WAYNE COUNTY REMONUMENTATION  
PEER GROUP COMMITTEE

Register of Deeds Stamp & File Number

RC 1344

4. Lot No. \_\_\_\_\_, Recorded Plat \_\_\_\_\_

5. Private Claims \_\_\_\_\_

I, Kenneth S. Wilkerson, in a field survey on October 28, 19 93, do hereby certify that under requirements of P.A. 74, Michigan P.A. of 1970, the corner points mentioned in lines 1 and 2 above were in conformance with regulations and rules therefore as required in the current manual of survey instructions of the United States Department of the Interior, Bureau of Land Management or by a decree of a Court of Law and/or that the corner points mentioned in lines 3, 4 and 5 above were in conformance with the rules of the Michigan Board of Land Surveyors or by a Decree of a Court of Law, established, re-established, monumented, re-monumented, recovered, found as expressed below:

NOTE: Not more than 4 corners, all in the same town and range, may be recorded on this certificate.

A. Description of original monument and accessories and/or subsequent restoration:

- G-07 Set Post - GLO - NO GLO WITNESSES REMAIN
- Fd. Iron - B of T
- Fd. 1/2" rebar in mon. box, L. 22713, P. 463 - 02/13/86
- NE 78.21 face of FP
- SE 64.19 brass tag in W face PP
- SW 54.26 brass tag W face PP
- NW 68.68 face of FP

B. Description of corner evidence found and/or method applied in restoring or reestablishing corner:

- G-07 Fd. 1/2" iron in mon. box per L. 22713, P. 463

C. Description of monument for corner and accessories established to perpetuate locating the position of the corner:

Set WC remonumentation washer and OHM KSW 21584 cap on iron.

- G-07 047 AZ 68.11 OHM tag in SE face PP
- 135 AZ 64.12 WCRC tag in SW face PP
- 220 AZ 54.20 WCRC tag in NW face PP
- 347 AZ 68.60 1/2" rod in conc. base fence cor.

The selected location is accepted as the best evidence of the original corner.


A	B	C	D	E	F	G	H	I	J	K	L	M
2	6	5	4	3	2	1						
3												
4	7	8	9	10	11	12						
5												
6	18	17	16	15	14	13						
7												
8	19	20	21	22	23	24						
9												
10	30	29	28	27	26	25						
11												
12	31	32	33	34	35	36						
13												

FOREST E. YOUNG & ASSOCIATES  
REGISTERED PROFESSIONAL SURVEYORS  
MICHIGAN STATE BOARD OF LAND SURVEYORS

93 DEC 15 PM 5:06

Signed by: *Kenneth S. Wilkerson*

Date: Nov 30 1993

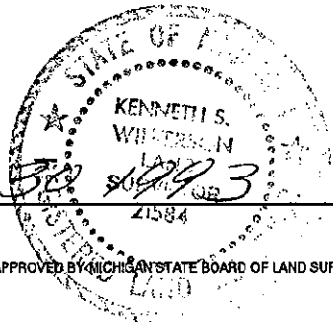

Drafted By: Kenneth S. Wilkerson  
Surveyor's Michigan License No. 21584

FORM APPROVED BY MICHIGAN STATE BOARD OF LAND SURVEYORS, JAN. 28, 1971  
REVISED MAY 14, 1975  
REVISED JAN., 1983

Orchard, Hiltz & McCliment, Inc.  
34935 Schoolcraft Road \* Livonia, Michigan 48150 \* Phone: (313) 522-6711

*2R  
11KD*