

FEB 28 1994

RC 1345

COMMISSION

LAND CORNER RECORDATION CERTIFICATE
Filing Requirement of Act 74, Mich. P.A. 1970

LI27042PA367

For corners in

WAYNE

County:

ROMULUS TOWNSHIP #13

Located in:

Corner Code #

1. Public Land Survey		T <u>3 S</u>	R <u>9 E</u>	G-12
		T _____	R _____	_____
		T _____	R _____	_____
		T _____	R _____	_____
2. Property Controlling in Section	S _____	T _____	R _____	_____
	S _____	T _____	R _____	_____
3. Miscellaneous Property in Sec.	S _____	T _____	R _____	_____
	S _____	T _____	R _____	_____

Compliance with
ACT 345, P.A. 1990

APPROVED ON: 12-15-93
WAYNE COUNTY REMONUMENTATION
PEER GROUP COMMITTEE

Register of Deeds Stamp & File Number

4. Lot No. _____, Recorded Plat _____

5. Private Claims _____

I, Kenneth S. Wilkerson, in a field survey on October 28, 19 93
do hereby certify that under requirements of P.A. 74, Michigan P.A. of 1970, the corner points mentioned in lines 1 and 2 above were in conformance with regulations and rules therefore as required in the current manual of survey instructions of the United States Department of the Interior, Bureau of Land Management or by a decree of a Court of Law and/or that the corner points mentioned in lines 3, 4 and 5 above were in conformance with the rules of the Michigan Board of Land Surveyors or by a Decree of a Court of Law; established, re-established, monumented, re-monumented, recovered, found as expressed below:

NOTE: Not more than 4 corners, all in the same town and range, may be recorded on this certificate.

A. Description of original monument and accessories and/or subsequent restoration:

G-12 Set Post - GLO - NO GLO WITNESSES REMAIN
Fd. Iron Pipe - B of T

G-12 L. 21092, P. 339 - 06/19/80

NE 48.49 spike in NE face T 10" stump
SE 38.88 spike in SW face 10" oak
NW 49.23 spike in NE face 18" ash

B. Description of corner evidence found and/or method applied in restoring or reestablishing corner:

G-12 Fd. conc. mon.

NNE 75.70 WCRC tag in NW face MBT P
NE 48.49 nail in NW face 29" twin stump
SE 38.88 nail in SW face 19" oak Fd
NNW 42.92 WCRC tag NE face 23" ash

C. Description of monument for corner and accessories established to perpetuate locating the position of the corner:

Set WC remonumentation washer and OHM KSW 21584 cap on iron.

G-12 N 30 E 70.33 Top nut on hyd.
S 35 E 38.50 OHM tag in NE face 14" oak
N 80 W 23.20 OHM tag in N face 6" ash
N 40 W 48.95 WCRC tag in S face 14" ash

The selected location is accepted as the best evidence of the original corner.

Signed by: [Signature]

Date: 12-15-93


Drafted By: Kenneth S. Wilkerson
Surveyor's Michigan License No. 21584

Orchard, Hiltz & McCliment, Inc.
34935 Schoolcraft Road * Livonia, Michigan 48150 * Phone: (313) 522-6711

A	B	C	D	E	F	G	H	I	J	K	L	M
2	6	5	4	3	2	1						
3												
4	7	8	9	10	11	12						
5												
6	18	17	16	15	14	13						
7												
8	19	20	21	22	23	24						
9												
10	30	29	28	27	26	25						
11												
12	31	32	33	34	35	36						
13												

FOREST E. JOHNSON
REGISTER OF DEEDS
WAYNE COUNTY, MI

93 DEC 15 PM 5:00

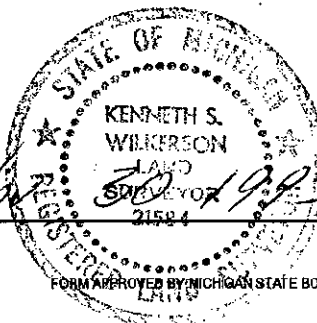

FORM APPROVED BY MICHIGAN STATE BOARD OF LAND SURVEYORS, JAN. 28, 1971
REVISED MAY 14, 1975
REVISED JAN., 1983

2R
11K1