

**SURVEY &
REMONUMENTATION**

RC 1450

APR 25 1995

LAND CORNER RECORDATION CERTIFICATE
Filing Requirement of Act 74, Mich. P.A. 1970

LI27794PA326

G-13 Page 1

COMMISSION

For corners in

Wayne

Located in: Romulus Corner Code

County

- | | | | |
|---------------------------------------|-------------------------|--------------|---------------|
| 1. Public Land Survey | T <u>3</u> S | R <u>9</u> E | <u>G-13</u> ✓ |
| | T _____ | R _____ | _____ |
| | T <u>4²S</u> | R <u>9E</u> | <u>G-01</u> |
| | T _____ | R _____ | _____ |
| 2. Property Controlling In Section | S _____ | T _____ | R _____ |
| | S _____ | T _____ | R _____ |
| 3. Miscellaneous Property in Sec. | S _____ | T _____ | R _____ |
| | S _____ | T _____ | R _____ |
| 4. Lot No. _____, Recorded Plat _____ | | | |
| 5. Private Claims _____ | | | |

Compliance with
ACT 345, P.A. 1990

APPROVED ON: 12/9/94 WCAO
WAYNE COUNTY REMONUMENTATION
PEER GROUP COMMITTEE

Register of Deeds Stamp and File Number

I, Kenneth S. Wilkerson in a field survey on 11/04/1994
do hereby certify that under requirements of P.A. 74, Michigan P.A. of 1970, the corner points mentioned in lines 1 and 2 above were in conformance with regulations and rules therefore as required in the current manual of survey instructions of the United States Department of the Interior, Bureau of Land Management, or by a decree of a Court of Law and/or that the corner points mentioned in lines 3, 4 and 5 above were in conformance with the rules of the Michigan Board of Land Surveyors or by a Decree of a Court of Law, established, re-established, monumented, re-monumented, recovered, found as expressed below.

NOTE: Not more than 4 corners, all in the same town and range, may be recorded on this certificate.

	A	B	C	D	E	F	G	H	I	J	K	L	M
2	6		5		4		3		2		1		
3													
4	7		8		9		10		11		12		
5													
6	18		17		16		15		14		13		
7													
8	19		20		21		22		23		24		
9													
10	30		29		28		27		26		25		
11													
12	31		32		33		34		35		36		
13													

A. Description of original monument and accessories and/or subsequent restorations:

- 01/01/1816 G.L.O. Set post
 10" POPLAR N 1 W 90 LINKS (59.40') (GONE)
 9" POPLAR N 18 E 94 LINKS (62.04') (GONE)

(Witnesses Continued on Back ...)

B. Description of corner evidence found and/or method applied in restoring or reestablishing corner:

Fd. 1/2" iron rod (1.05' below surface) in mon. box w/cover in asph. pvm't. @ int. of cl's. Dist. to F-13 = 2636.82. (R), 2636.82' (M), Dist to H-13 = 2643.41' (R), 2643.01' (M)

C. Description of monument for corner and accessories established to perpetuate locating the position of the corner:

11/04/1994 Wilkerson 21584 O.H.M. Remon

SET W.C.R. WASHER AND CAP OVER CORNER.
CORNER COMMON G-1 HURON TWP.


- 1 W.C.R. TAG P.P. N 50 E 45.00'
- 6 W.C.R. TAG P.P. S 40 E 46.20'
- 9 W.C.R. TAG P.P. N 30 W 45.60'
- 10 W.C.R. TAG P.P. S 50 W 47.45'
- 13 ANGLE TO RIGHT B.S.F-13 = 180°36'-50"

\$ 16.00 MISCELLANEOUS RECORDING
21 DEC 94 3:42 P.M. RECEIPT # 930
REGISTERED LAND

We conclude that after careful study of the record documentation and field observations, that this corner is accepted as the best available evidence of the position of the original corner.

Signed by [Signature]
 Drafted by Kenneth S. Wilkerson
 Surveyor's Michigan License No. 21584

Date

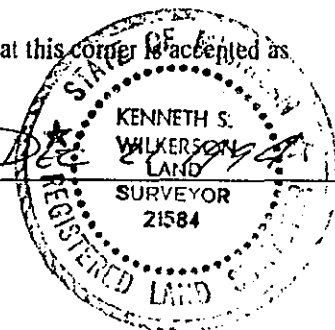

Orchard, Hiltz and McClint, Inc. 34935 Schoolcraft Road Livonia, MI 48150

2-R
14-N Misc

A. (Continued) Description of original monument and accessories and/or subsequent restorations:

01/01/1816		G.L.O.	Set post
	CORNER IS COMMON WITH G-1, HURON TWP.		
01/01/1930	W.C.R.C.	B/T	Fd. iron
1	ED. POLE NE 44.32'		
2	W.C.R. SIGN P. SE 31.37' (GONE)		
3	F. P. SE 47.61' (GONE)		
4	CROSS ON 24" CULV. SW 34.84' (GONE)		
5	15" ELM NW 66.44' (GONE)		
11	DIST = 2636.82' TO F-13		
12	DIST = 2643.41 TO H-13		
13	ANGLE TO R B.S.F-13 = 180-45'-50"		
04/28/1970	W.C.R.C.		Fd. iron in mon. box
1	ED. POLE NE 44.99'		
6	M.B.T. POLE SE 45.58'		
7	M.B.T. P. SW 65.29' (GONE)		
8	M.B.T.P. NW 68.92' (GONE)		

L127794PA327