

999 8 8 1994

COMMISSION

RC 1365

LI 27059 PA 139

LAND CORNER RECORDATION CERTIFICATE
Filing Requirement of Act 74, Mich. P.A. 1970

For corners in

Table with columns: WAYNE (County), Located In:, Corner Code ##. Rows include Public Land Survey, Property Controlling in Section, and Miscellaneous Property in Sec.

4. Lot No. , Recorded Plat
5. Private Claims

I. RAPHAEL J. LANDINI in a field survey on NOVEMBER 18, 19 93, do hereby certify that under requirements of P.A. 74, Michigan P.A. of 1970, the corner points mentioned in lines 1 and 2 above were in conformance with regulations and rules therefore as required in the current manual of survey instructions of the United States Department of the Interior, Bureau of Land Management or by a decree of a Court of Law and/or that the corner points mentioned in lines 3, 4 and 5 above were in conformance with the rules of the Michigan Board of Land Surveyors or by a Decree of a Court of Law; established, re-established, monumented, re-monumented, recovered, found as expressed below:

NOTE: Not more than 4 corners, all in the same town and range, may be recorded on this certificate.

A. Description of original monument and accessories and/or subsequent restoration:

Table listing original monuments: W. ASH 12 S 25 W 23 (15.2) (GONE), HICKORY 10 N 53 W 19 (12.5) (GONE), etc. with bearings, distances, and measurements.

B. Description of corner evidence found and/or method applied in restoring or reestablishing corner:

Table listing corner evidence: WAYNE COUNTY ROAD COMM. MON. IN BOX 1971, WAYNE COUNTY DPS ROADS 1/2" IRON IN MON BOX 1988, BOLT SIGN BASE, etc.

C. Description of monument for corner and accessories established to perpetuate locating the position of the corner:

I-1 T3S R9E STANDARD 4" DIA X 36" CONC. MON. WITH 3'8" IRON ROD; REMON. BRASS DISK WITH CAP RUL RLS 16933 IN MON. BOX, SELECTED LOCATION IS ACCEPTED BY CONTRACTOR AND GENERALLY ACCEPTED BY PROFESSIONAL SURVEYORS AS THE BEST AVAILABLE EVIDENCE OF THE POSITION OF THE ORIGINAL CORNER.



Table listing found monuments: FOUND WERE TAG S FACE DE POLE, 3/8" IRON IN CONC. MONUMENT IN MON BOX, FOUND WCRC TAG SW FACE DE POLE, etc.

Signed by Raphael J. Landini, Surveyor's Michigan License No. 16933

Date DECEMBER 16, 1993

Compliance with ACT 345, P.A. 1990
APPROVED ON: 12-21-93
WAYNE COUNTY REMONUMENTATION PEER GROUP COMMITTEE

Register of Deeds Stamp & File Number

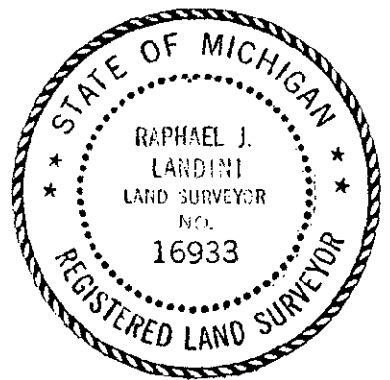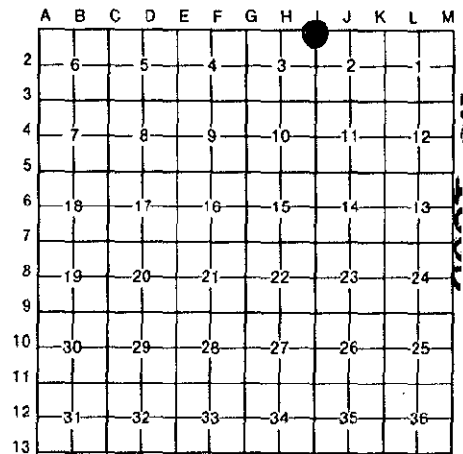

FOREST E. YOUNGBLOOD
REGISTER OF DEEDS
MICHIGAN STATE DEPT. OF NATURAL RESOURCES

Handwritten initials '2K' and '11/17' at the bottom right.