

LAND CORNER RECORDATION CERTIFICATE

Filing Requirement of Act 74, Mich. P.A. 1970

For corners in

WAYNE (County)	Located in:	Corner Code #
1. Public Land Survey	T <u>3S</u> R <u>9E</u>	<u>I 3</u>
	T _____ R _____	_____
	T _____ R _____	_____
	T _____ R _____	_____
2. Property Controlling in Section	S _____ T _____ R _____	_____
	S _____ T _____ R _____	_____
3. Miscellaneous Property in Sec.	S _____ T _____ R _____	_____
	S _____ T _____ R _____	_____
4. Lot No. _____, Recorded Plat _____		
5. Private Claims _____		

LI 27059 PA 141

Compliance with ACT 345, P.A. 1990

APPROVED ON: 12-21-93
WAYNE COUNTY REMONUMENTATION
PEER GROUP COMMITTEE

Register of Deeds Stamp & File Number

I, RAPHAEL J. LANDINI, in a field survey on NOVEMBER 18, 19 93, do hereby certify that under requirements of P.A. 74, Michigan P.A. of 1970, the corner points mentioned in lines 1 and 2 above were in conformance with regulations and rules therefore as required in the current manual of survey instructions of the United States Department of the Interior, Bureau of Land Management or by a decree of a Court of Law and/or that the corner points mentioned in lines 3, 4 and 5 above were in conformance with the rules of the Michigan Board of Land Surveyors or by a Decree of a Court of Law; established, re-established, monumented, re-monumented, recovered, found as expressed below:

NOTE: Not more than 4 corners, all in the same town and range, may be recorded on this certificate.

A. Description of original monument and accessories and/or subsequent restoration:

G.L.O.				
W. ASH	12 S28E	13 (8.6)	(GONE)	
SASSAFRAS	12 N81W	26 (17.2)	(GONE)	

WPA (1930S) CROSS				
30" POPLAR		NE 44.45	(GONE)	
18" ASH		SE 40.82	(GONE)	
18" ELM		SW 43.29	(GONE)	
ED POLE		NW 63.22	(GONE)	

FOUND IRON 0.35E AND 0.13 S OF CROSS

B. Description of corner evidence found and/or method applied in restoring or reestablishing corner:



WAYNE COUNTY ROAD COMM. 1970 IRON IN BOX	WAYNE COUNTY DPS ROADS 1989 1/2" IRON IN BOX
SIGNAL GUY POLE NE 64.28 (GONE)	WCRC TAG GUY POLE NE 71.20 (GONE)
ED POLE SE 93.33 (GONE)	WCRC TAG DE POLE SE 69.14 (MEAS.69.14)
MBT POLE SW 73.39 (GONE)	WCRC TAG DE POLE SW 71.05 (MEAS.71.05)
	+ CHISLED IN CONC. SIGN BASE NW 84.01 (GONE)

LCRC RC 294 L18669 P 74 IRON IN MON BOX
 PK TRAFFIC LT POLE N 40°E 64.66 (GONE)
 E BOLT UNION 76 SIGN N45°W 61.54 (GONE)
 PK NAIL IN MBT POLE S43°W 73.41 (GONE)

C. Description of monument for corner and accessories established to perpetuate locating the position of the corner:

FOUND MONUMENT WITH 1/2" IRON ROD, SET REMONUMENTATION BRASS DISK WITH CAP RJL RLS 16933, IN MON BOX. SELECTED LOCATION IS ACCEPTED BY CONTRACTOR AND IS GENERALLY ACCEPTED BY PROFESSIONAL SURVEYORS AS THE BEST AVAILABLE EVIDENCE OF THE POSITION OF THE ORIGINAL CORNER.

SET + CHISLED ON W BOLT OF METAL POLE	N50°E	71.70
FOUND WCRC TAG NE FACE DE POLE	S44°E	69.16
FOUND WCRC TAG NW FACE DE POLE	S56°W	71.05
SET + CHISLED NE COR. SIGN BASE	N42°W	85.75

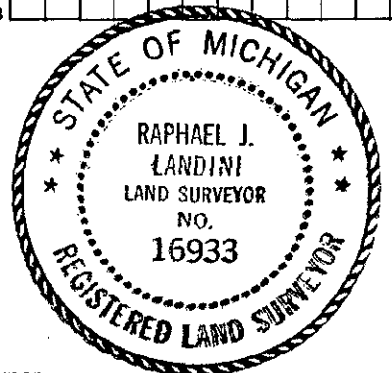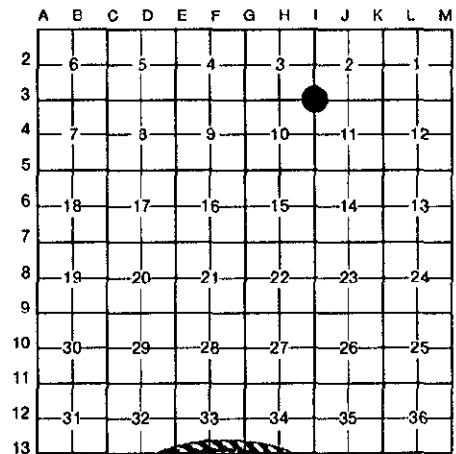

Signed by Raphael Landini Date DECEMBER 16, 1993

Surveyor's Michigan License No. 16933

93 DEC 22 AM 10:20
FOREST E. YOUNGblood
REGISTER OF DEEDS
WAYNE COUNTY, MI

2R
11/17